


T. 3S. R. 2 E.W.M.

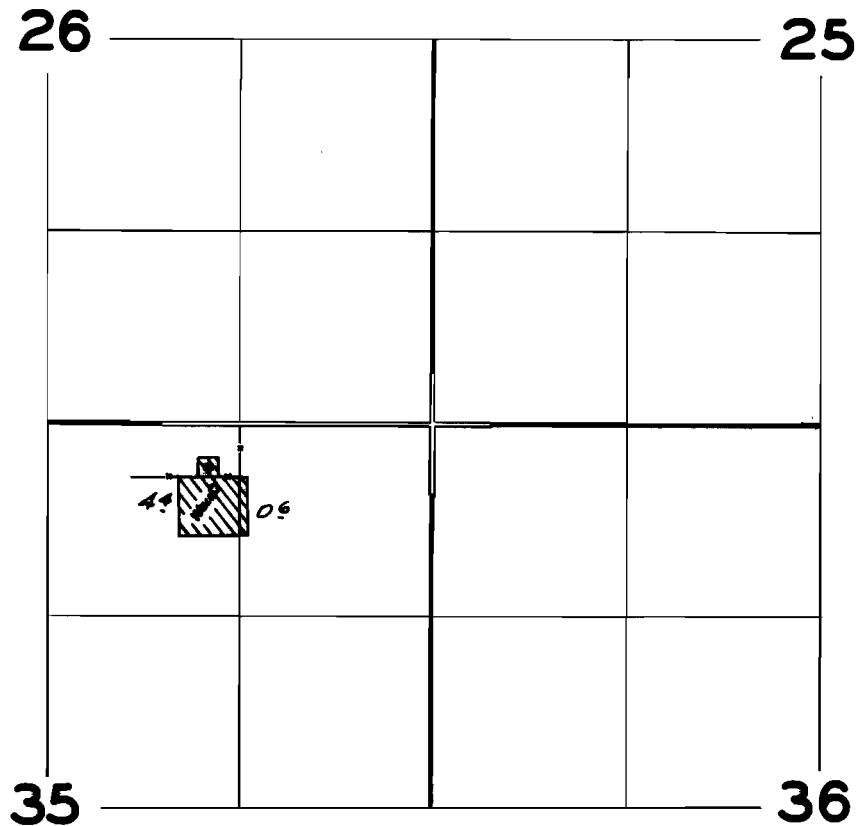

FINAL PROOF SURVEY
UNDER

Application No. G-456 Permit No. G-348
IN NAME OF

ETHEL M. VAN AVERY

Surveyed Mar. 31 1960, by R. H. Jackson