


T. 4S. R. IW.W.M.

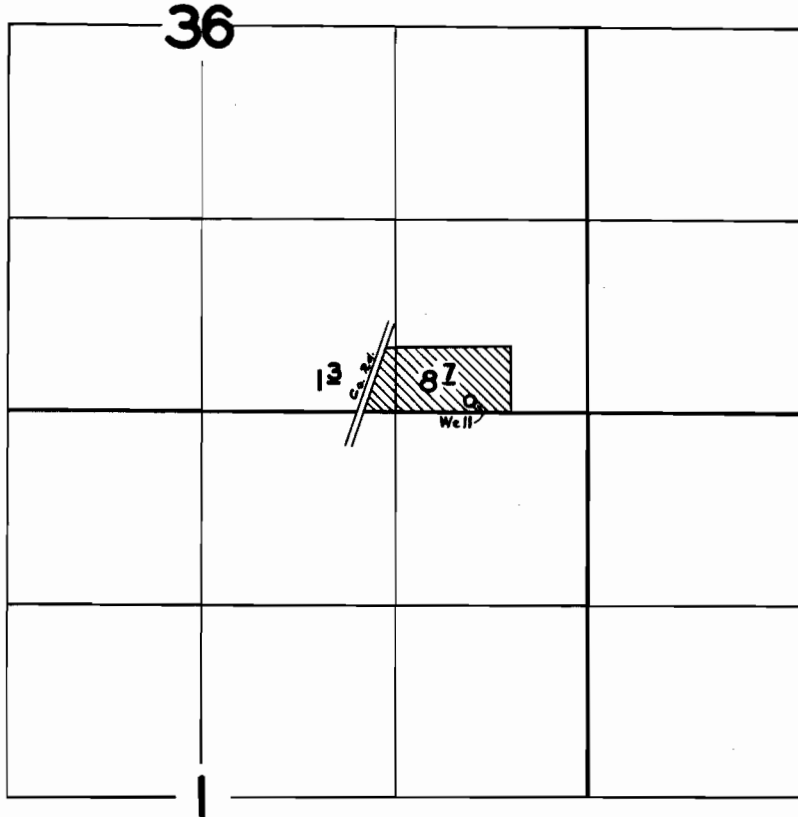

FINAL PROOF SURVEY
UNDER

Application No. G-659 Permit No. G-571
IN NAME OF

GUST ROSENBLAD

Surveyed APR. 30 1959, by M. BISH