


T.2S. R. 2E.W.M.

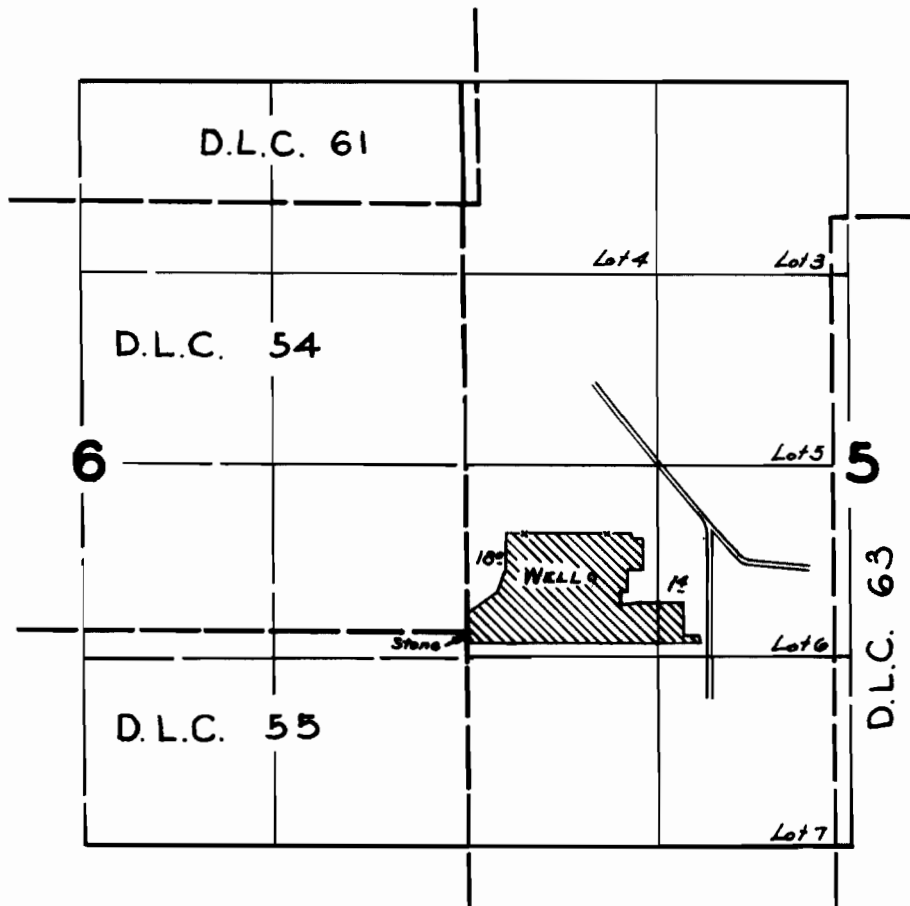

FINAL PROOF SURVEY
UNDER

Application No. G-717 Permit No. G-622
IN NAME OF

UNION HIGH SCHOOL DIST. NO. 5

Surveyed 20 APRIL 1960, by *R. Jackson*