


# T. 4S. R. 1E.W.M.

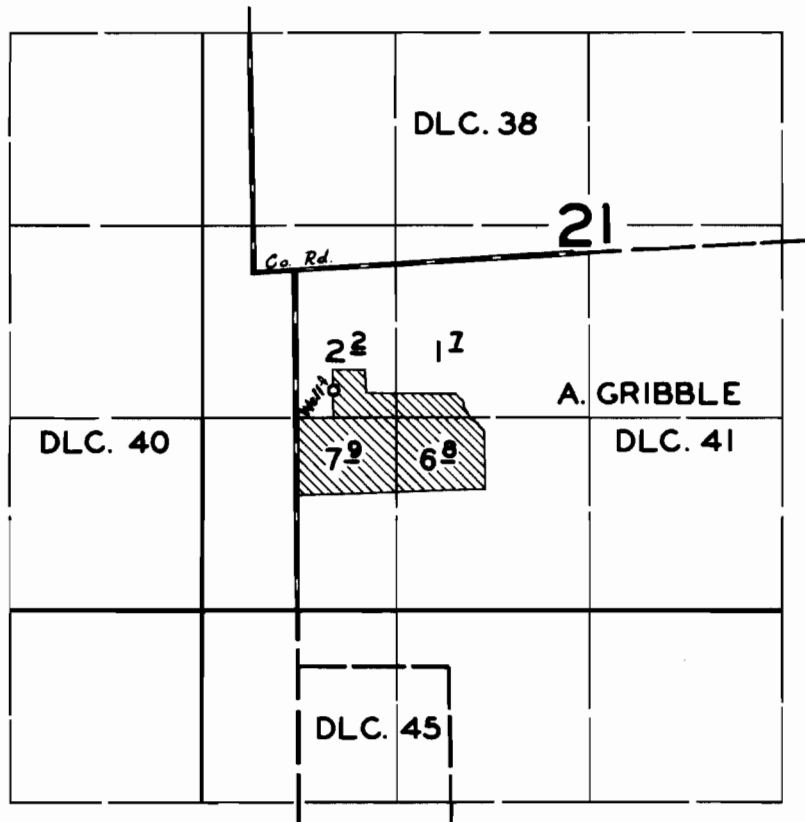

## FINAL PROOF SURVEY UNDER

Application No. G-1198 Permit No. G-1004  
IN NAME OF

IVAN PULLEY

Surveyed MAY 1 1959, by M. BISH