


T.4S. R.2 E.W.M.

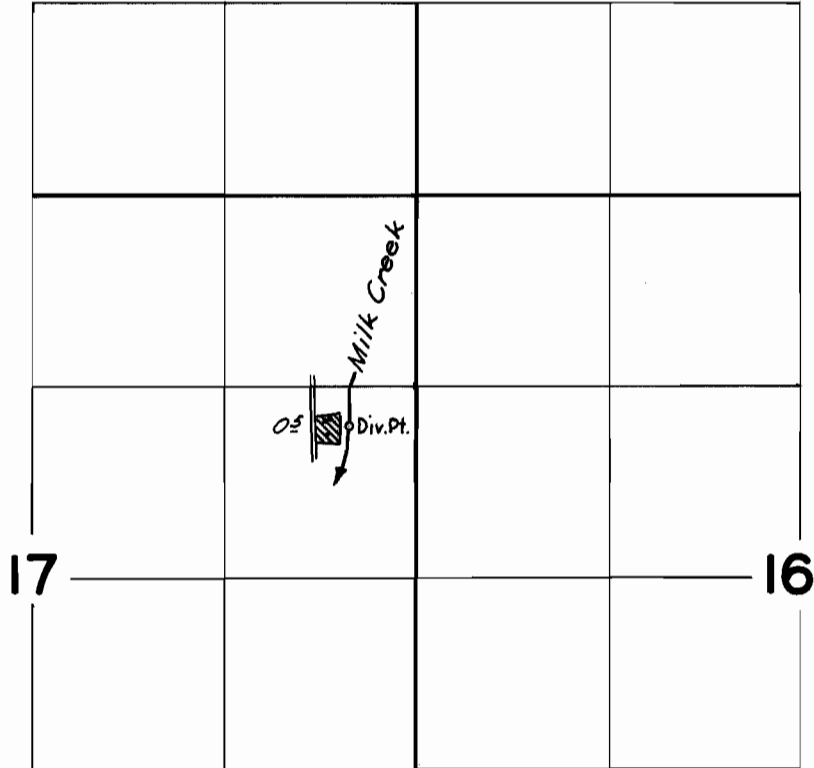

FINAL PROOF SURVEY  
UNDER

Application No. 25582.. Permit No. 20079.  
IN NAME OF

**STELLA A. HOWARD & BAYNE A. HOWARD**

Surveyed 20 April, 1960, by *R.H. Jackson*