


T.2S. R.2 E.W.M.

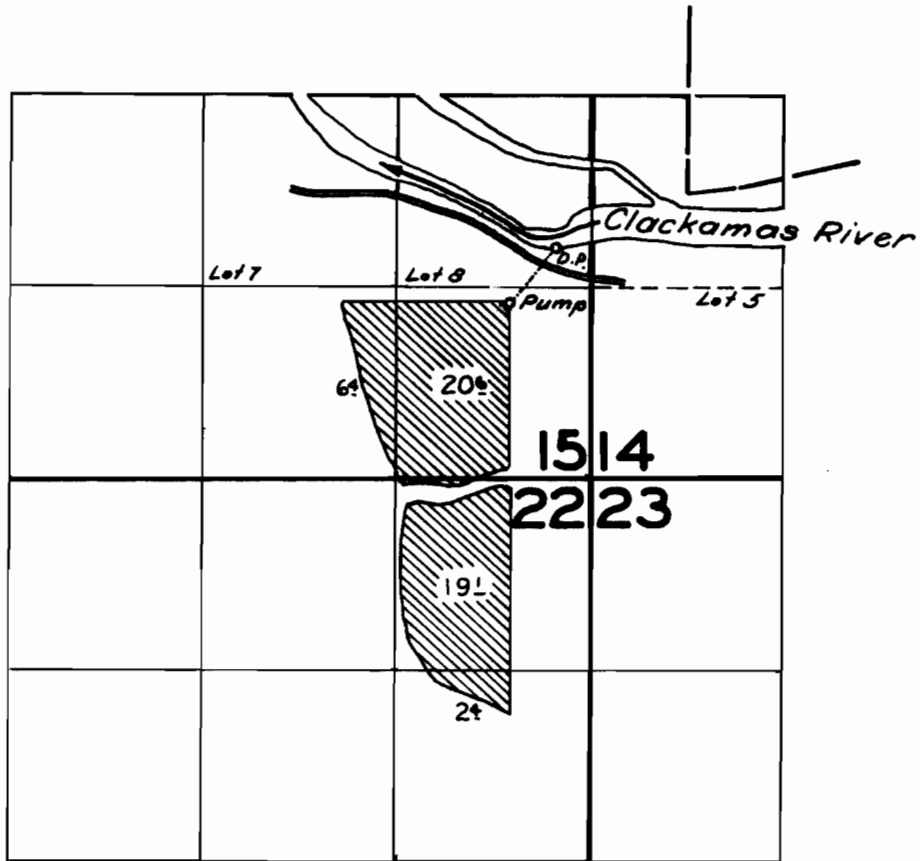

FINAL PROOF SURVEY
UNDER

Application No. 2627.8 Permit No. 2062.5
IN NAME OF

WILLIAM H. DICKMAN

Surveyed 19 April 1960, by R. H. Jackson