


T. 4S. R. 2E.W.M.

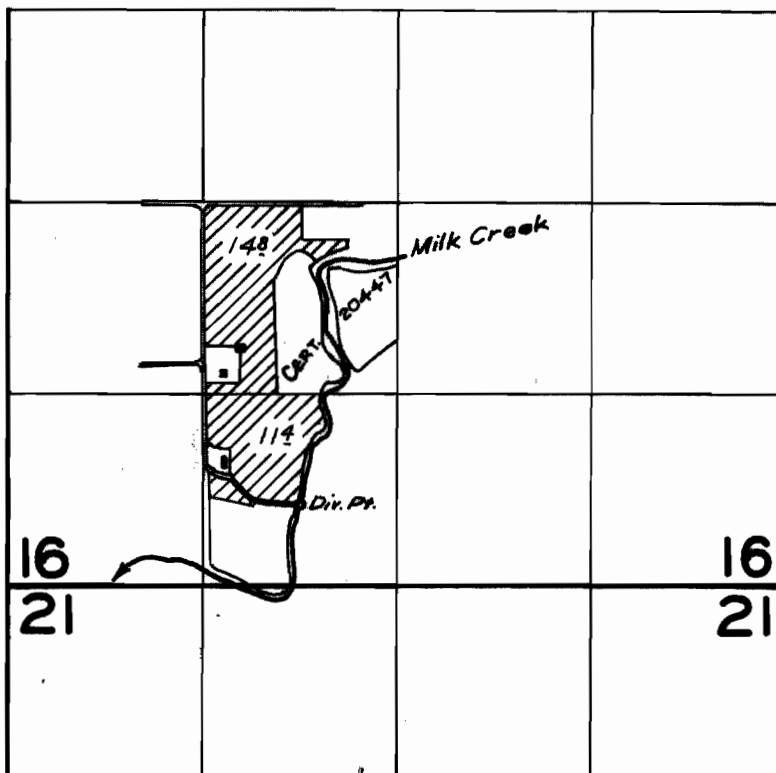

FINAL PROOF SURVEY
UNDER

Application No. ~~29414~~ Permit No. ~~23164~~
IN NAME OF

ENRIGHT A. & GAIL A. ELLIS

Surveyed 21 April 1960, by *D. Jackson*