


T. 3S. R. 2E. W.M.

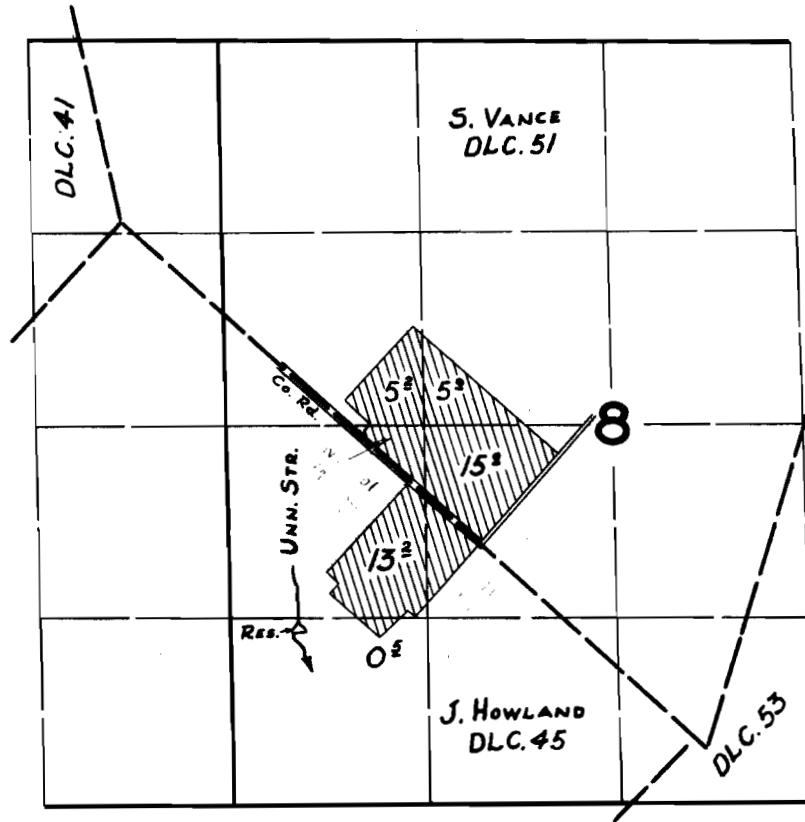

FINAL PROOF SURVEY

UNDER

Application No. R-30264 Permit No. R-1836  
30265 24067

IN NAME OF

RUDOLPH PAYLINAC

Surveyed July 9 1959, by R.H. JACKSON