


T. 3S. R. 2E. W.M.

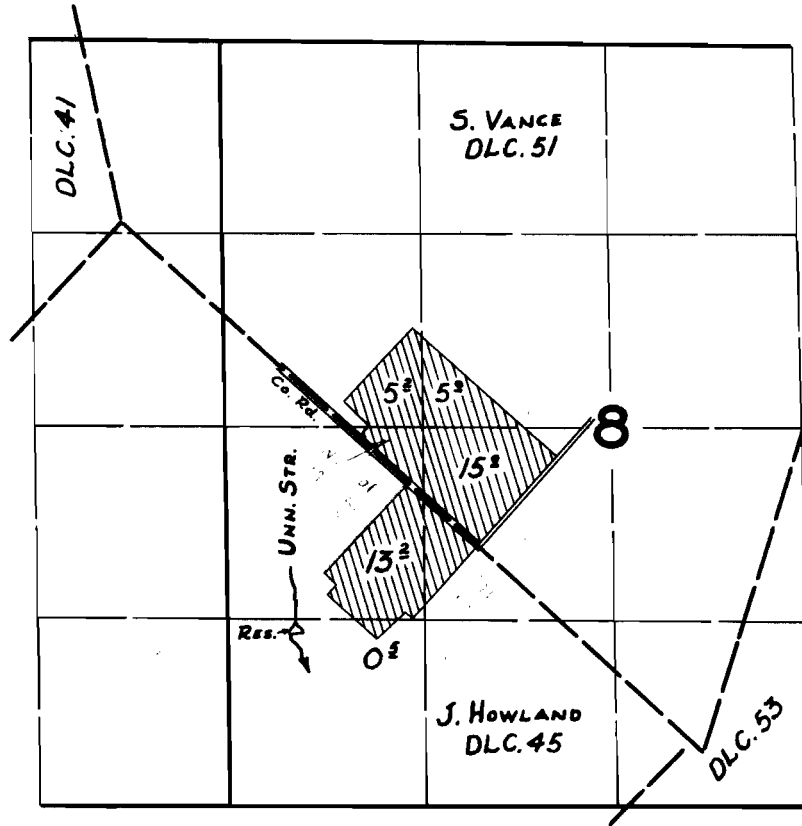

FINAL PROOF SURVEY

UNDER

Application No. R-30264 30265 Permit No. R-1836 24067

IN NAME OF

RUDOLPH PAYLINAC

Surveyed JULY 9 1959, by R. H. JACKSON