


T. 5S. R. 2E.W.M.

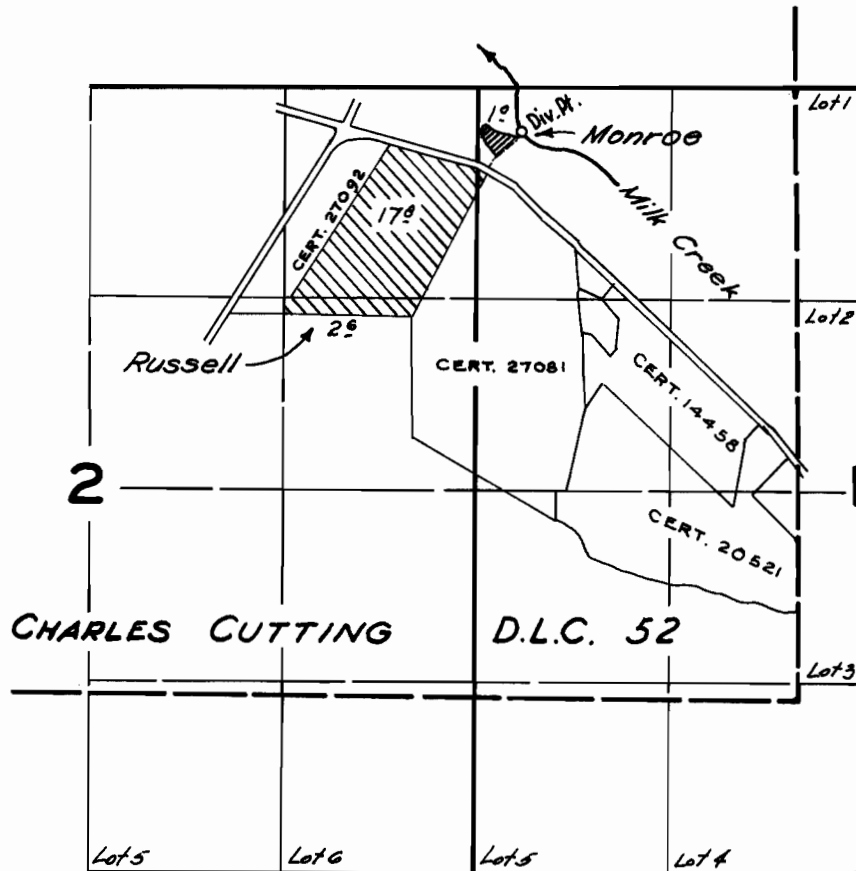

FINAL PROOF SURVEY
UNDER

Application No. 30804. Permit No. 24251...
IN NAME OF

WILLIAM A. MONROE - FRANK RUSSELL

Surveyed 28 April 1959, by M. Bish
21 April 1960, by R. Jackson