


T. 3S. R. 2E. W.M.

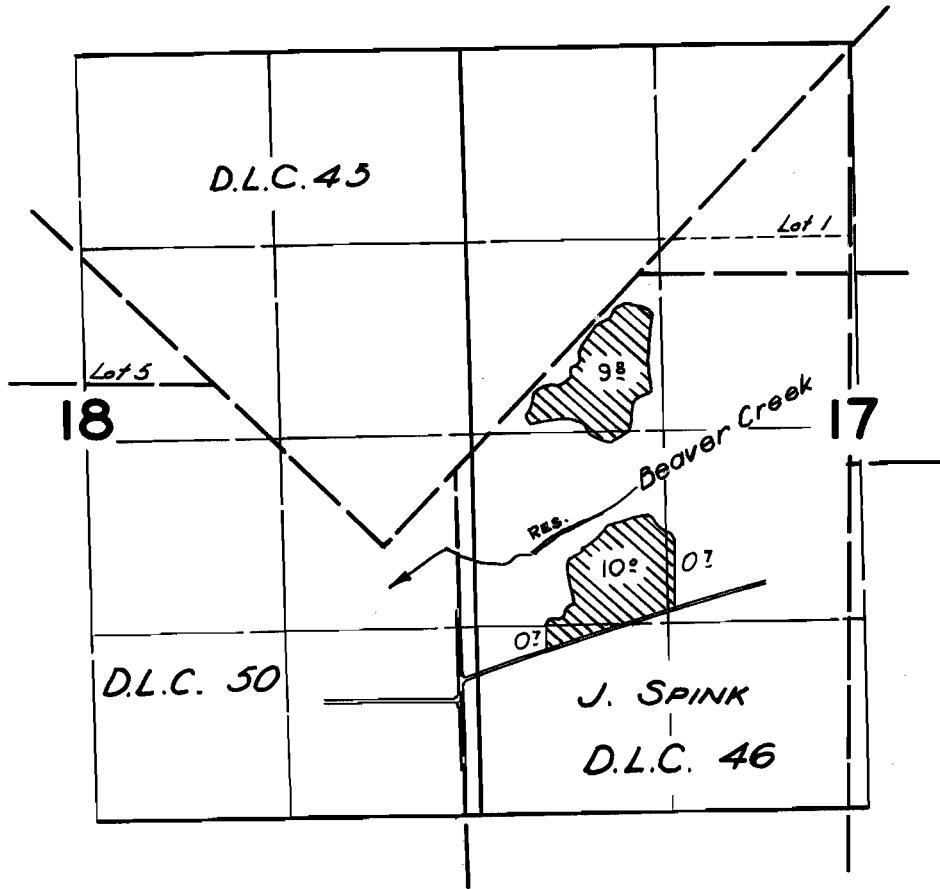

FINAL PROOF SURVEY
UNDER

Application No. ^{R-30850} 30851... Permit No. ^{R-1877} 24276...
IN NAME OF

JOHN H. & M. BERNICE PRYOR

Surveyed 21 April 1960, by *R. Jackson*