


T. 3S. R. 2E. W.M.

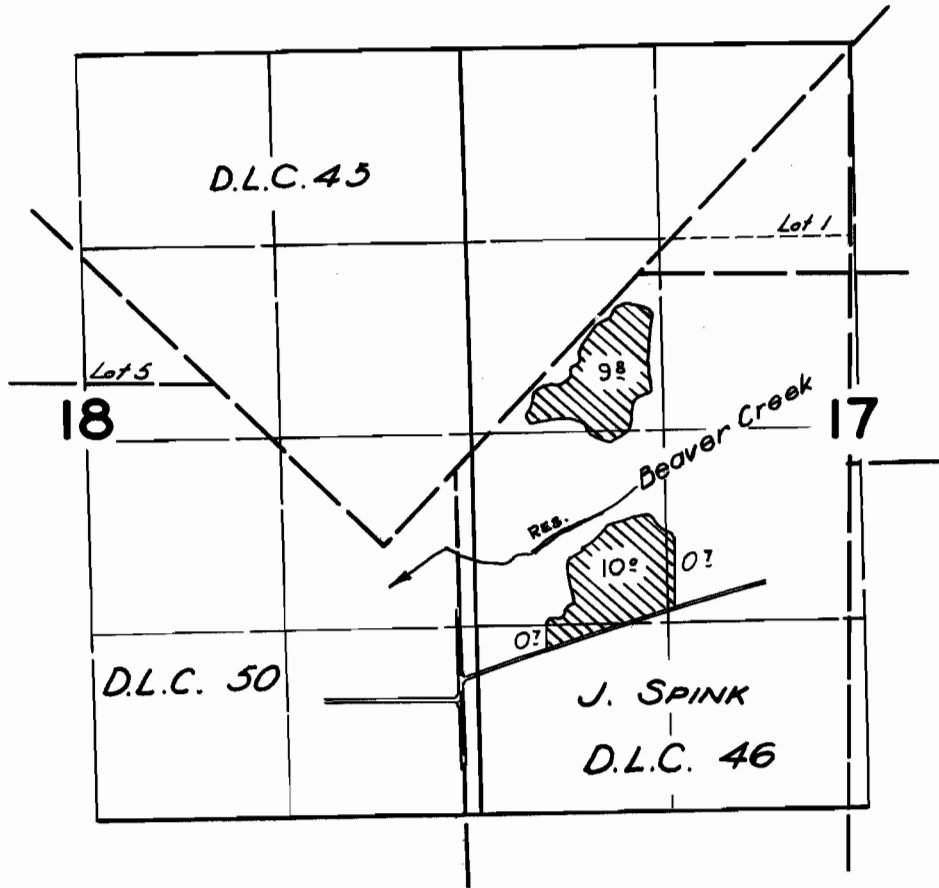

FINAL PROOF SURVEY
UNDER

Application No. ^{R-30850} ~~30851~~ Permit No. ^{R-1877} ~~24276~~
IN NAME OF

JOHN H. & M. BERNICE PRYOR

Surveyed 21 April 1960, by *R. Jackson*