


T.3S. R.1E.W.M.

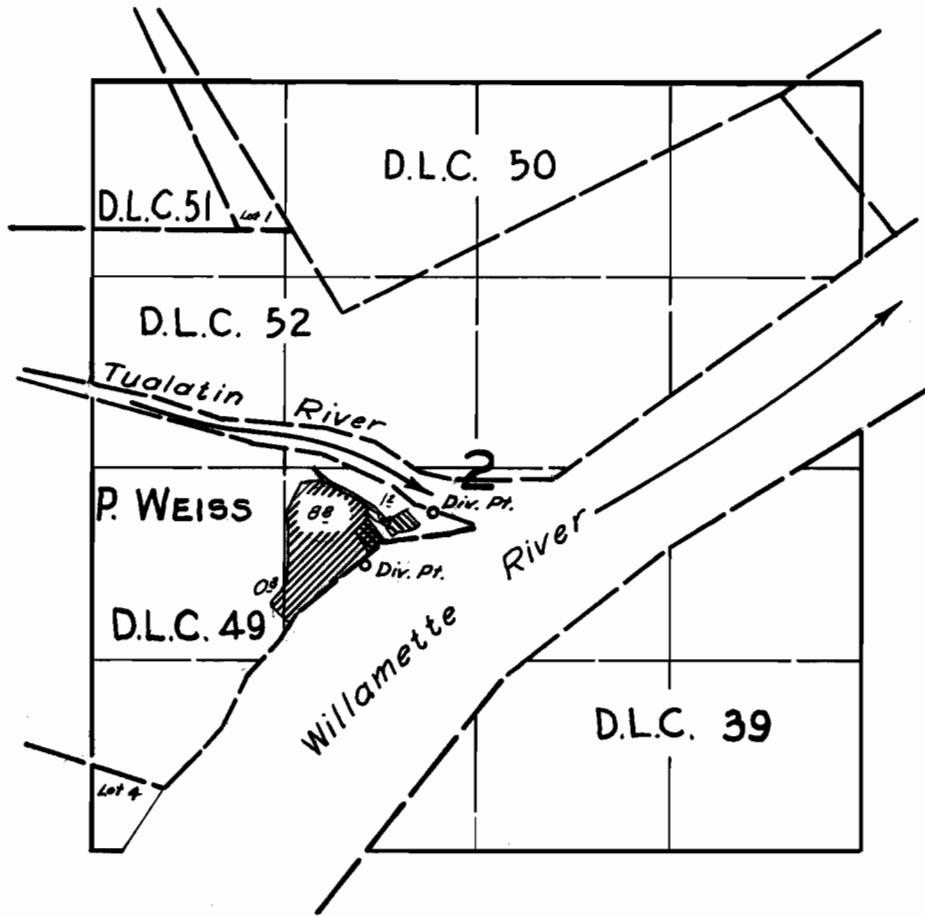

FINAL PROOF SURVEY
UNDER

Application No. 30916... Permit No. 24337.
IN NAME OF

JOHN N. MULKEY

Surveyed March 28 1960, by *RH Jackson*