


T.2S. R.2E.W.M.

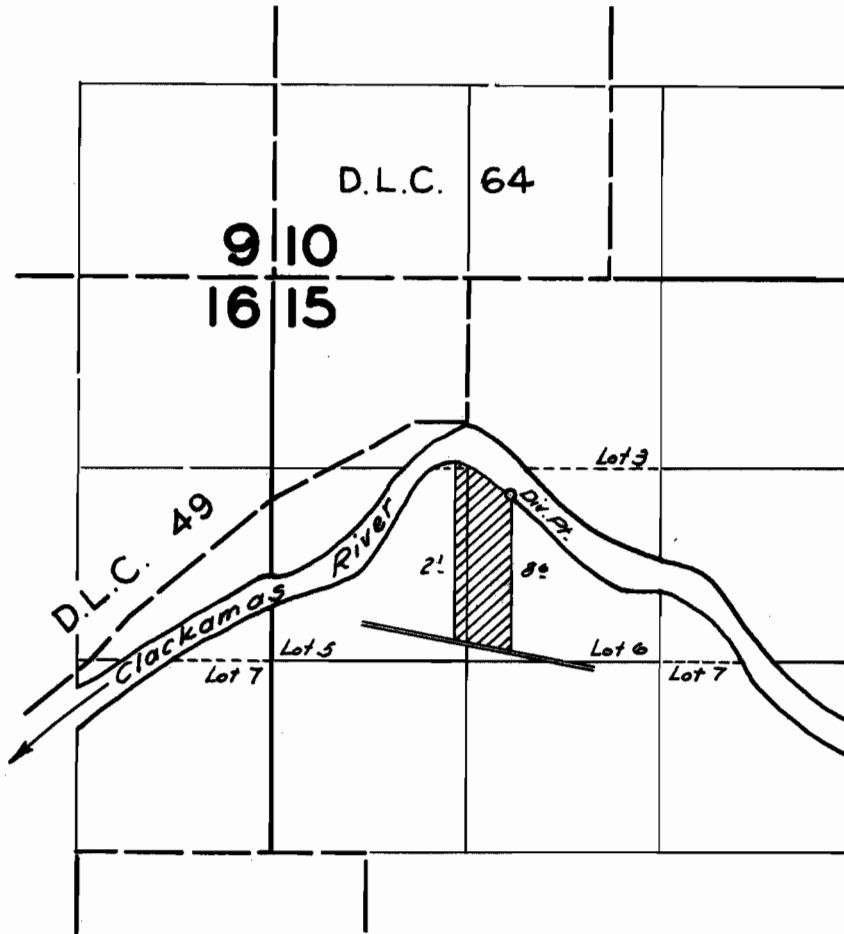

**FINAL PROOF SURVEY**  
UNDER

Application No. 31004... Permit No. 24359.  
IN NAME OF

**CHARLES H. MILLER**

Surveyed 19 April 1960, by *P. Jackson*