


Lot # 5  
4 & 5 are  
reversed  
dlb  
6-3-66

# T.3 S. R. 2 E.W.M.

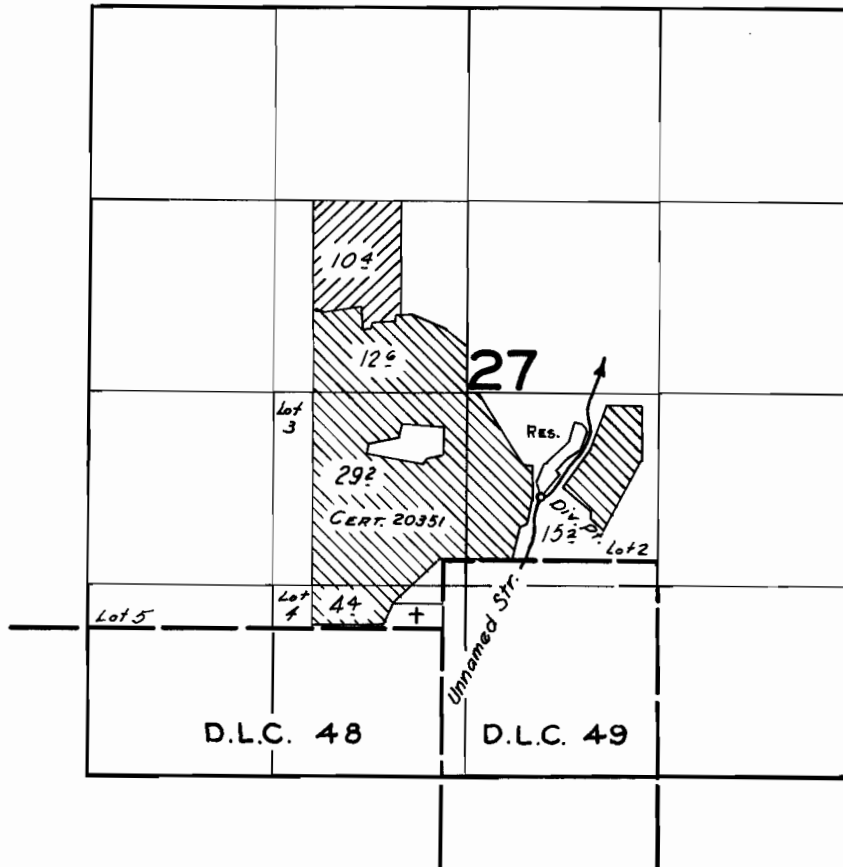

## FINAL PROOF SURVEY UNDER

R-31560 R-2020  
Application No. 31561... Permit No. 24905...  
IN NAME OF

**JOHN ROUSETT**

Surveyed Mar. 31, 1960, by *R. Jackson*