


T.2S. R.2 E.W.M.

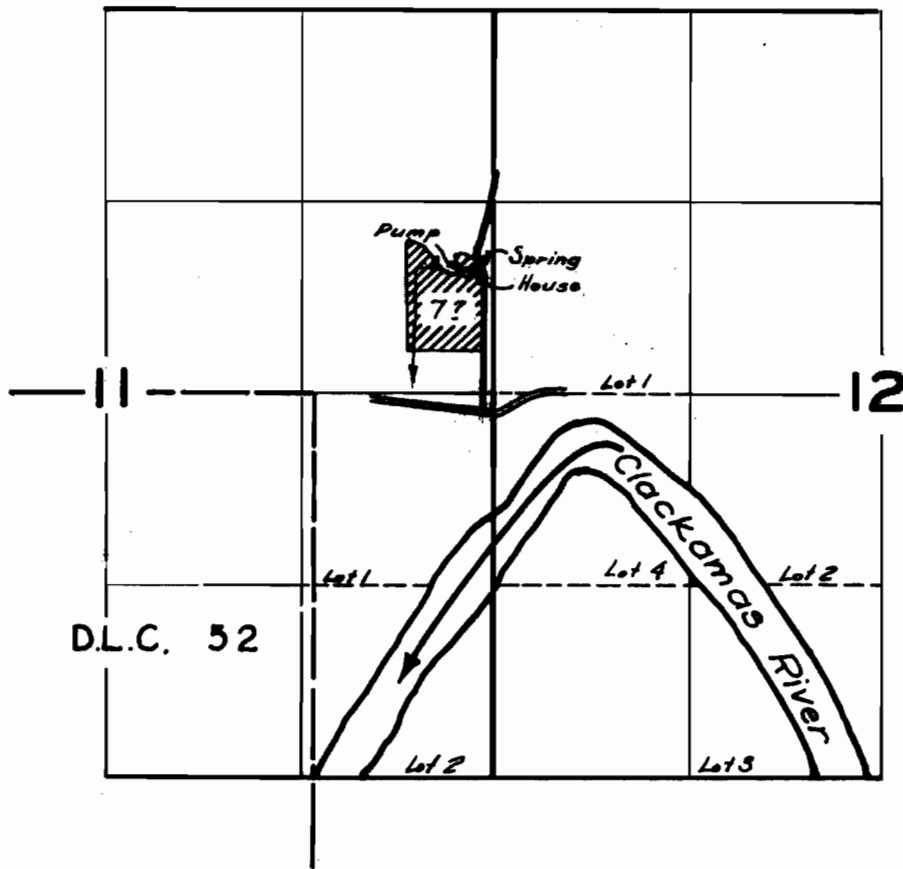

FINAL PROOF SURVEY
UNDER

Application No. 32066 Permit No. 25361...
IN NAME OF

RAYMOND C. & SIGNE SMITH

Surveyed April 20 1960, by *[Signature]*