


T. 5N. R. 4W. W.M.

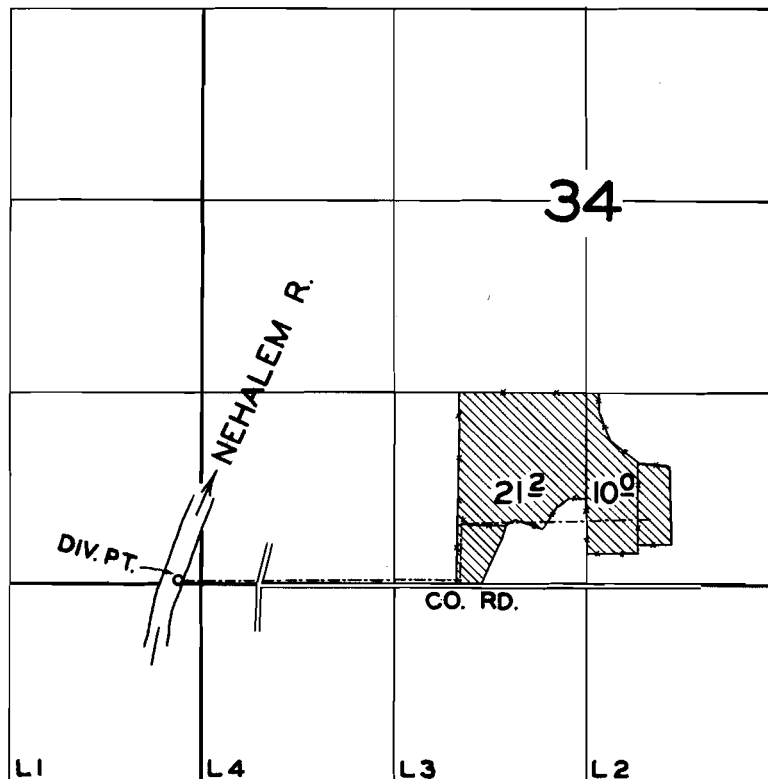

FINAL PROOF SURVEY
UNDER

Application No. 27589 Permit No. 21495
IN NAME OF

FRANCIS WRIGHT

Surveyed JULY 7 1959, by M. BISH