


T. 8N. R. 4W. W.M.

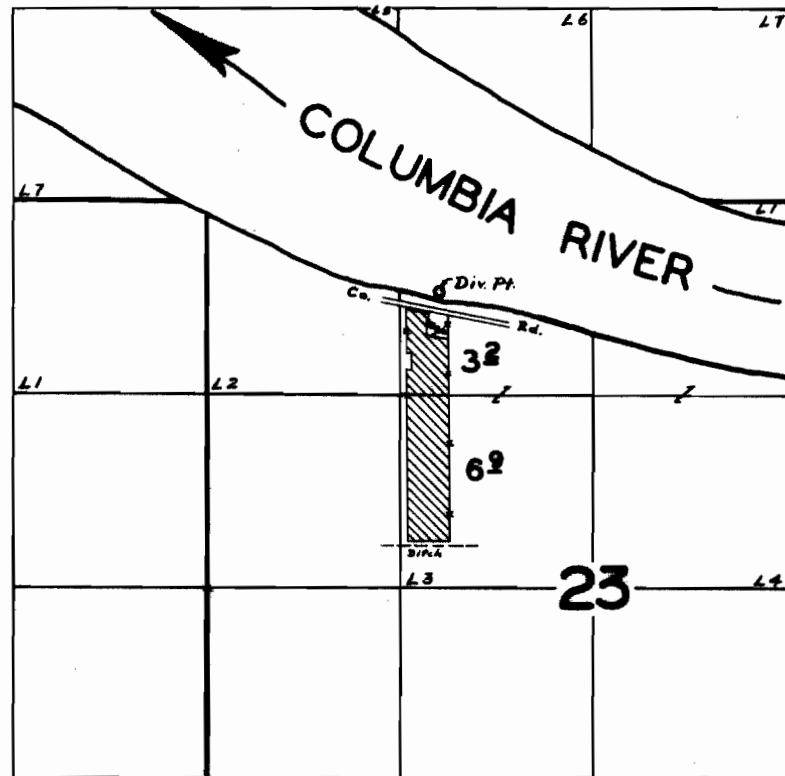

**FINAL PROOF SURVEY**  
UNDER

Application No. 29445 Permit No. 23178  
IN NAME OF

**JOHN W. & DAISY M. WILMARTH**

Surveyed JULY 7 1959 by M. BISH