


T. 6N. R. 2W. W.M.

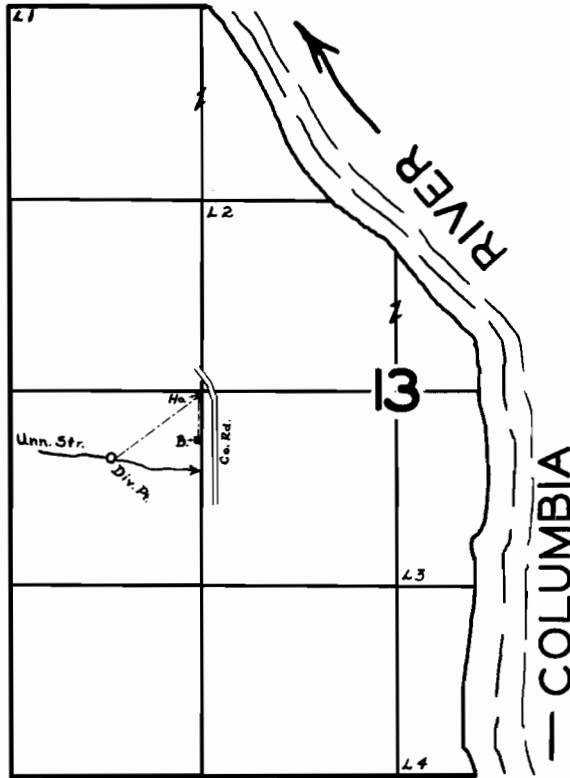

FINAL PROOF SURVEY
UNDER

Application No. 29953 Permit No. 23476
IN NAME OF

JOYCE N. McKAY

Surveyed JULY 9 1959, by M. BISH