


T.28S. R.13W.W.M.

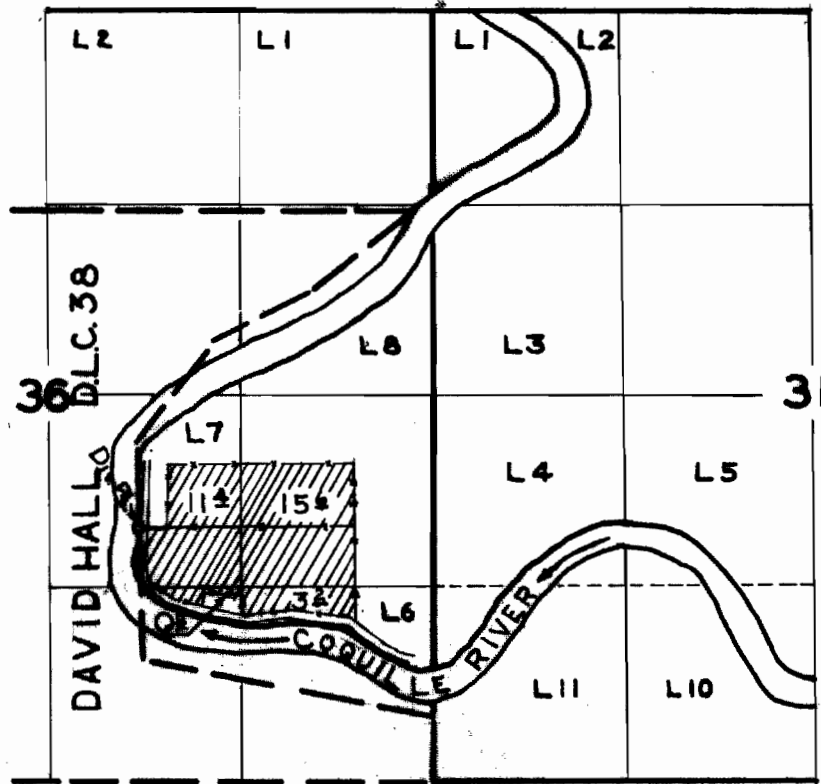

FINAL PROOF SURVEY
UNDER

Application No. 29856 Permit No. 23522
IN NAME OF

K. E. NIELSEN

Surveyed JUNE 13 1960, by M. BISH