


T.29&30S. R.12W.W.M.

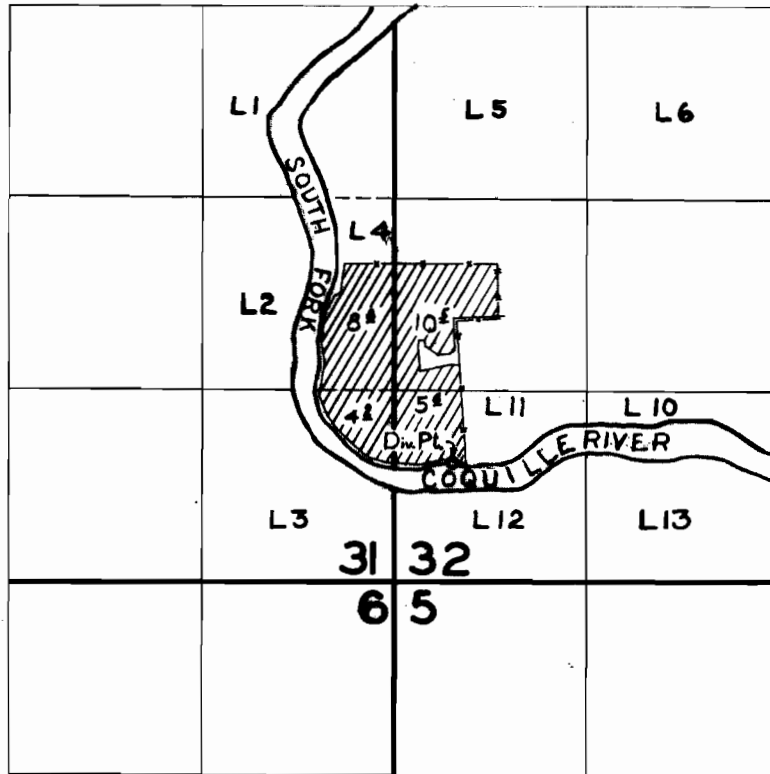

FINAL PROOF SURVEY
UNDER

Application No. 30076 Permit No. 23704
IN NAME OF

.....ORLIN CARL LETT.....

Surveyed JUNE 7 1960, by M. BISH.....