


T. 30S. R. 13W. W.M.

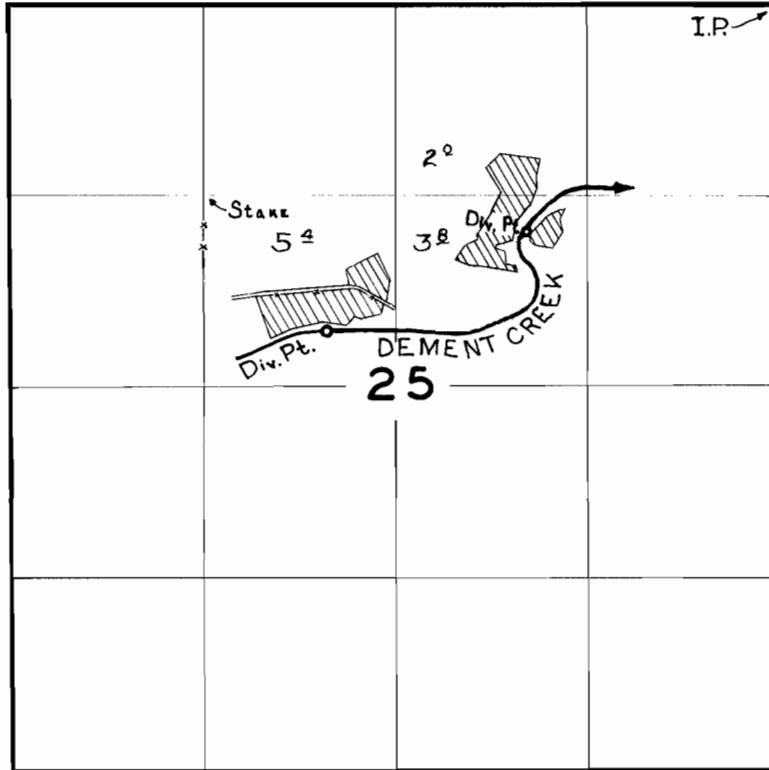

FINAL PROOF SURVEY
UNDER

Application No. 28357 Permit No. 23919
IN NAME OF

CHAS. W. CHANDLER

Surveyed JUNE 8 1960 by M. BISH