


T.29S. R.12W.W.M.

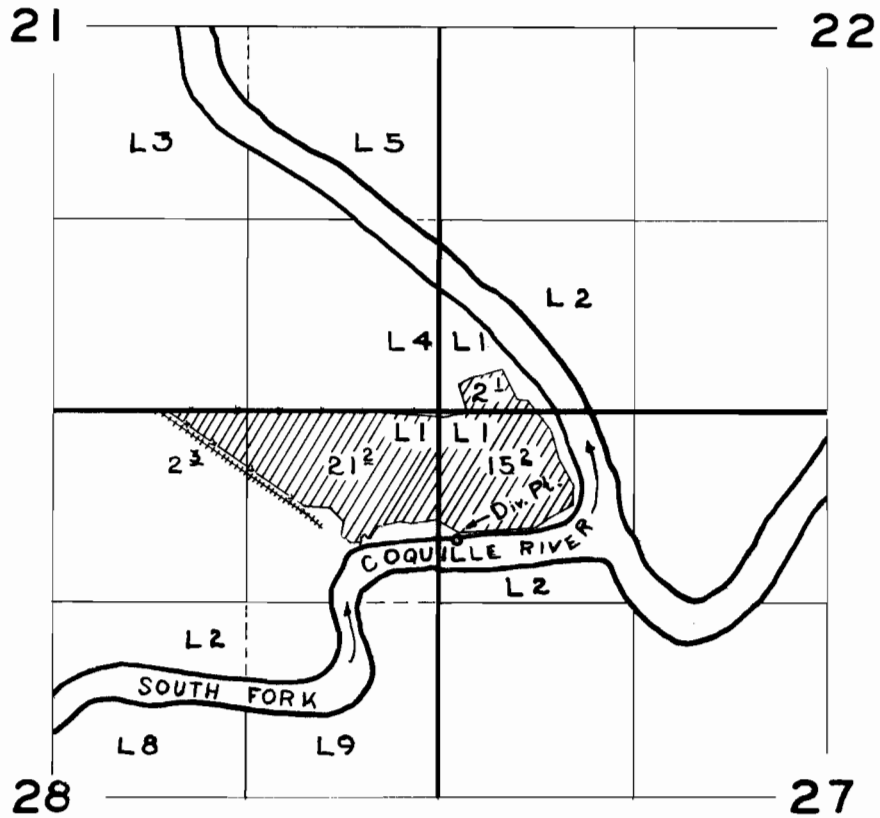

FINAL PROOF SURVEY
UNDER

Application No. 30519 Permit No. 24030
IN NAME OF

..... BEARL SEALS

Surveyed JUNE 8 1960, by M. BISH