


T.28S. R.12W.W.M.

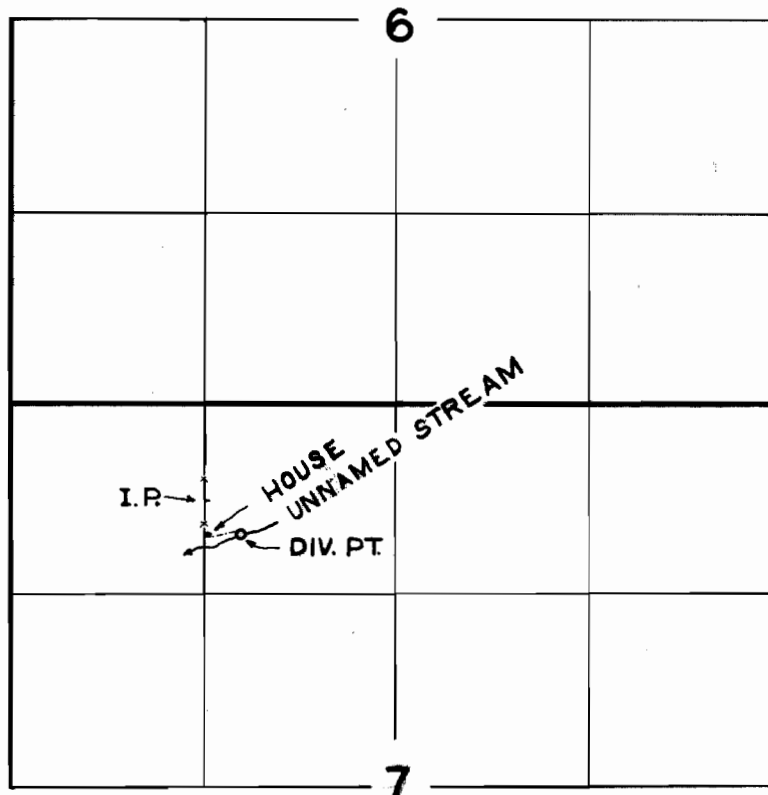

FINAL PROOF SURVEY
UNDER

Application No. 31009 Permit No. 24382
IN NAME OF

RUSSELL W. WILSON

Surveyed JUNE 13, 1960, by M. BISH