


T. 27 & 28 S. R. 11 W. W. M.

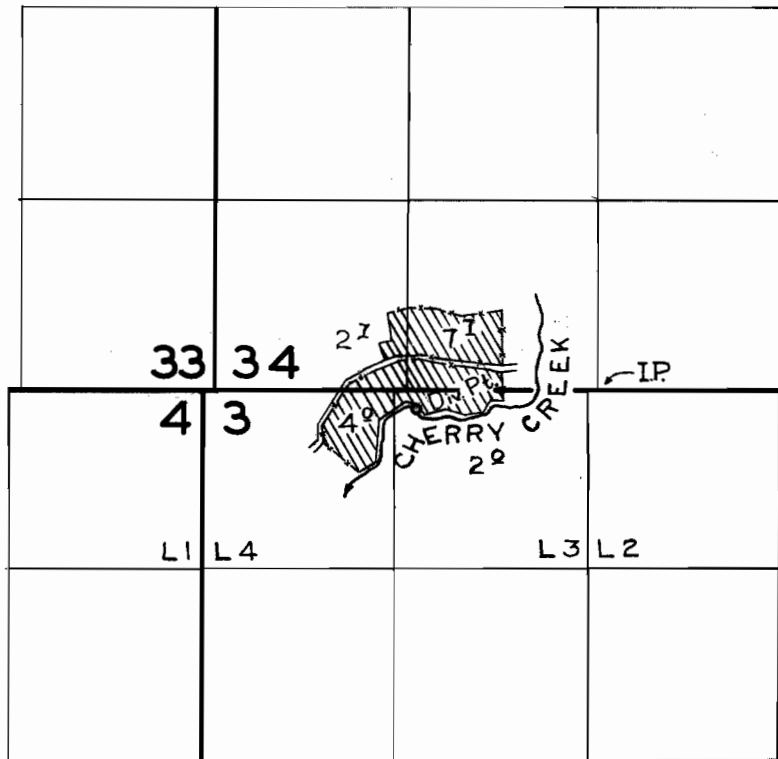

**FINAL PROOF SURVEY**  
UNDER

Application No. 31714..... Permit No. 25003.....  
IN NAME OF

.....S. E. McCARTHY.....

Surveyed JUNE 11, 1960, by M. BISH.....