


T.15 S.R.14&15 E.W.M.

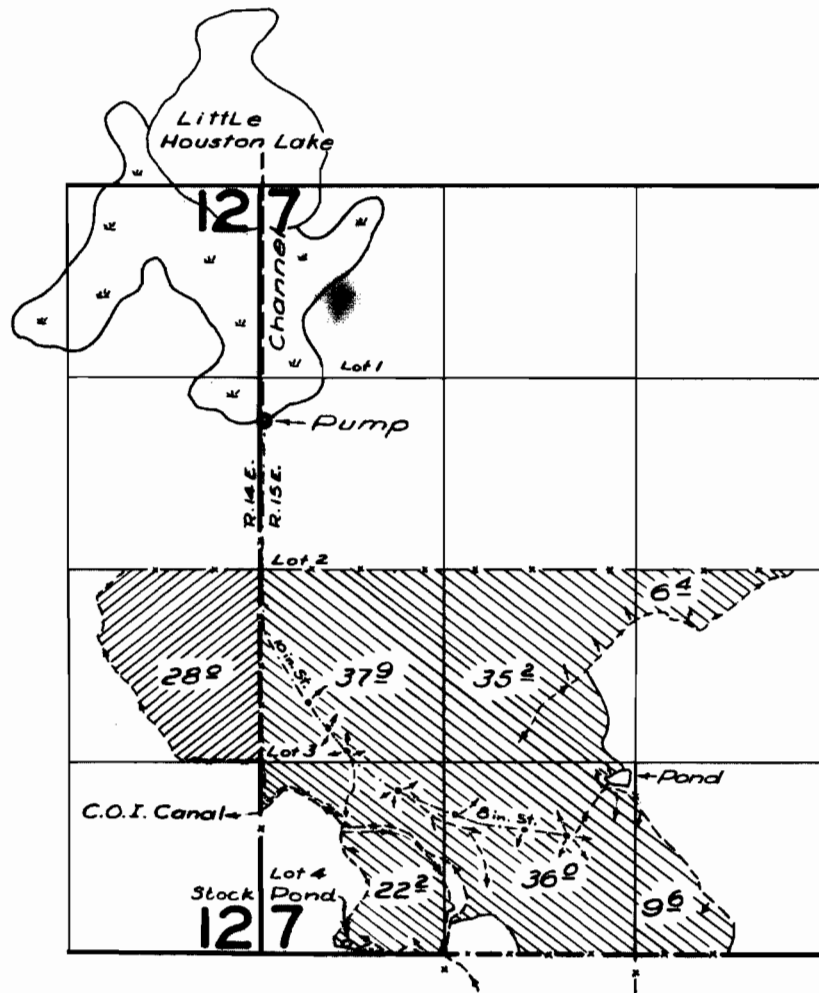

FINAL PROOF SURVEY UNDER

Application No. 29724 Permit No. 23401
IN NAME OF

H. G. ROCKWOOD

Surveyed 4.5 Oct 1969 by T. B. Bish