


T. 30S. R. 2W. W.M.

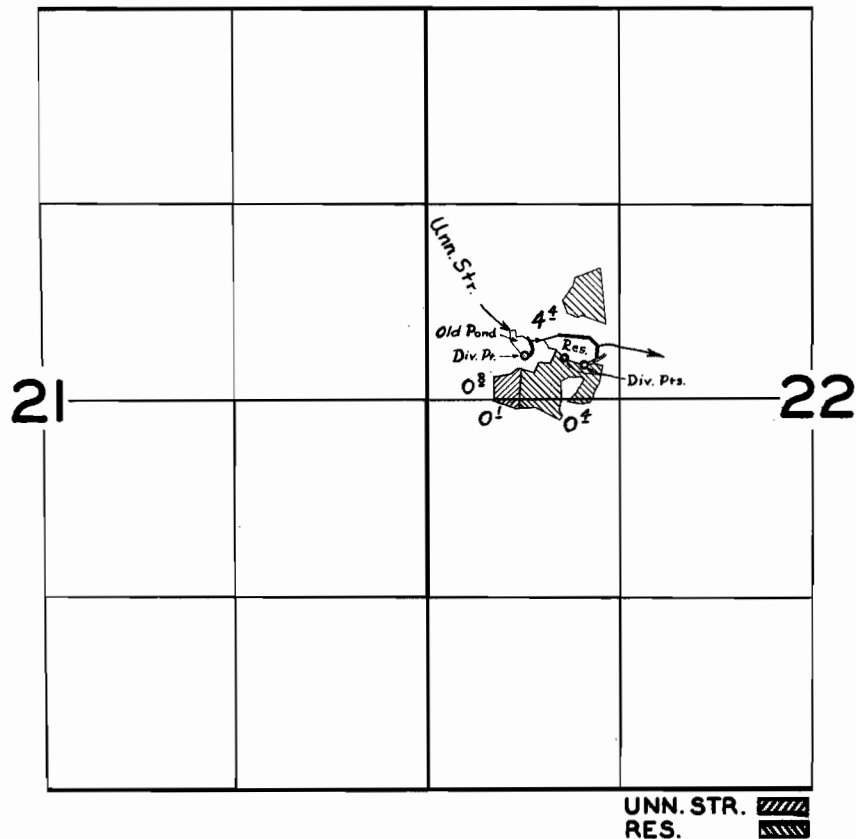

FINAL PROOF SURVEY
UNDER

R-29575 R-1733
Application No. 29576 Permit No. 23494
IN NAME OF

KENNETH L. LONG

Surveyed JUN. 17 1959, by M. BISH