


T. 32S. R. 6W. W.M.

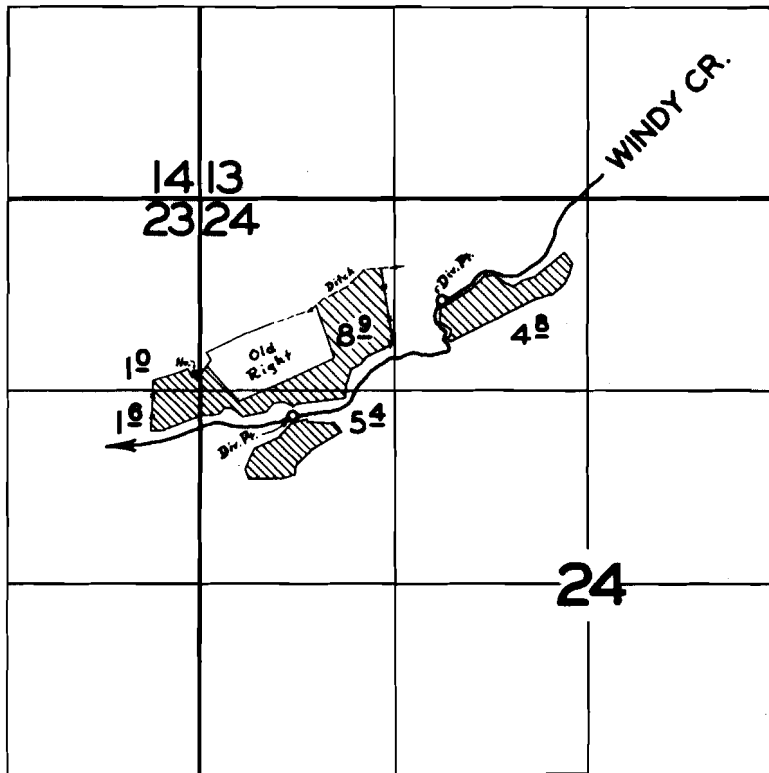

FINAL PROOF SURVEY
UNDER

Application No. 30297 Permit No. 23854
IN NAME OF

RICHARD L. VAN DUINE

Surveyed JUN. 19 1959, by M. BISH