


T. 7S. R. 27E. W.M.

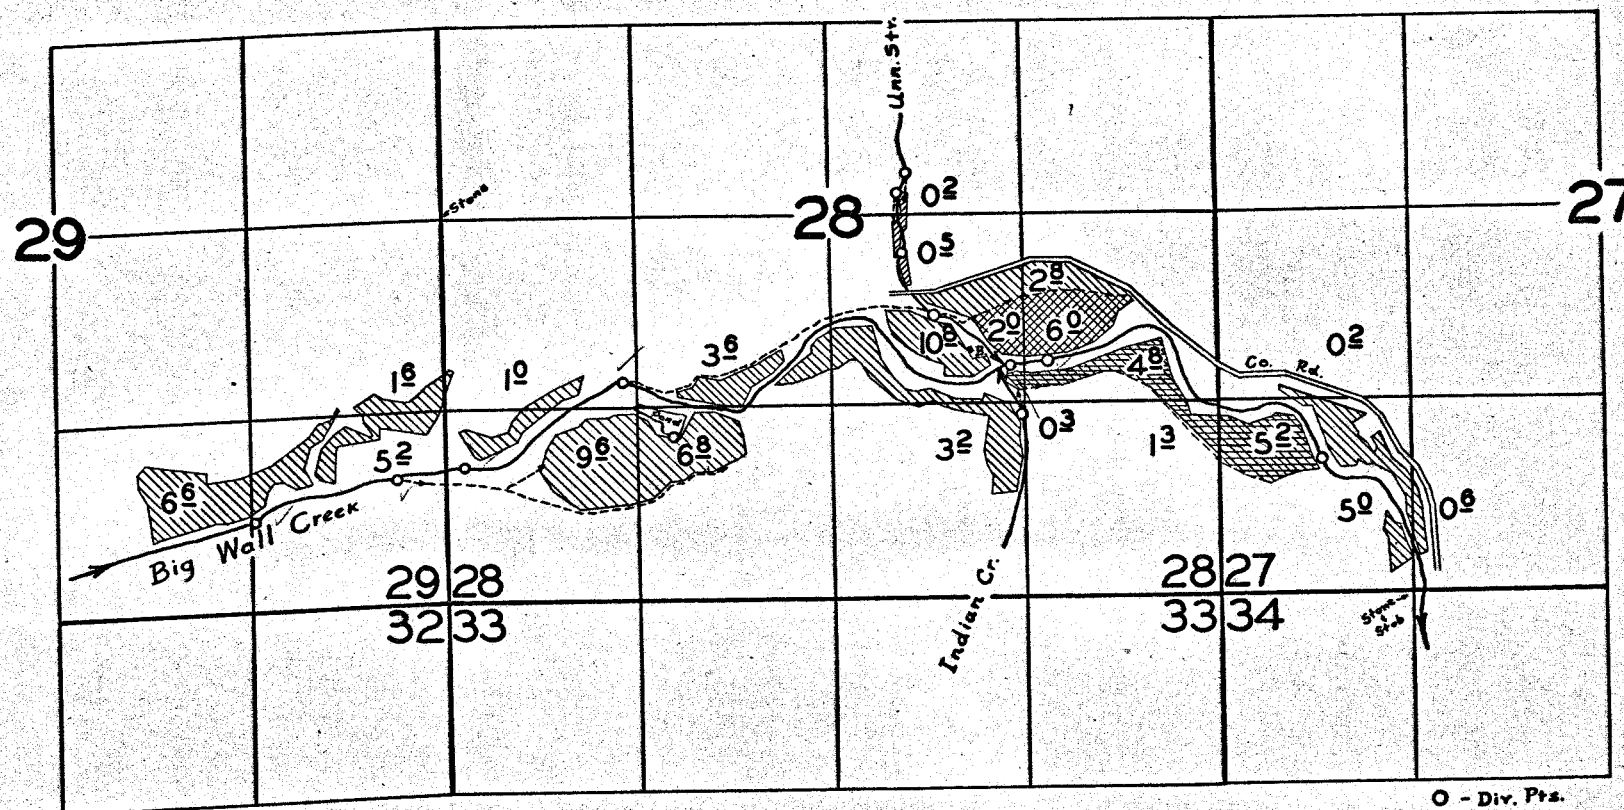

FINAL PROOF SURVEY

UNDER

Application No. 19393 Permit No. 15801

IN NAME OF

LYLE E. VAN DUSEN

Surveyed AUG. 10-11 1959, by M. BISH