


Per 22468
27960

T. 10S. R. 29E. W.M.

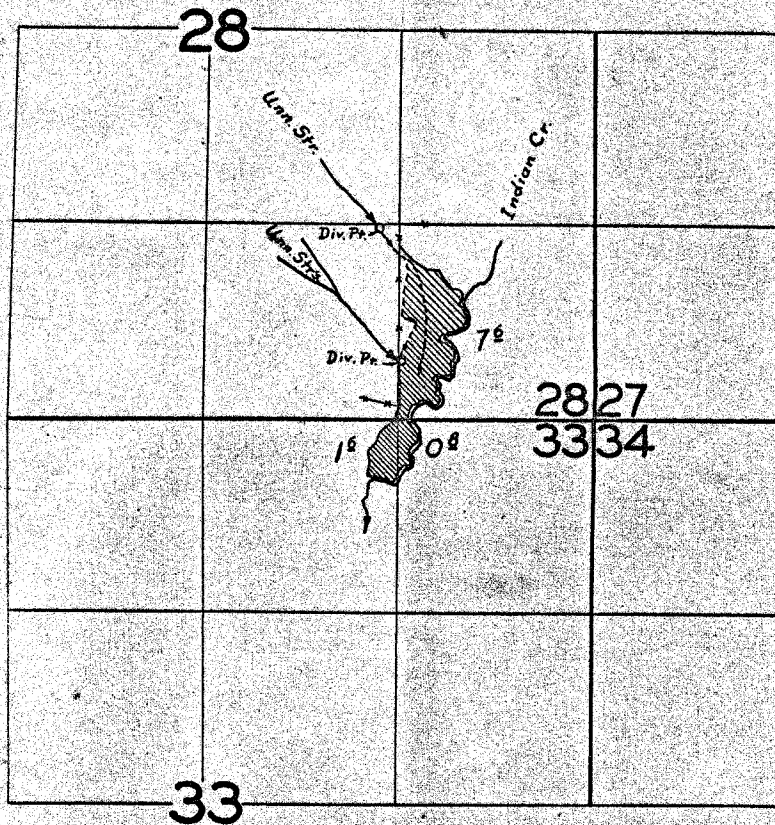

FINAL PROOF SURVEY

UNDER

Application No. 28575 Permit No. 22468

IN NAME OF

T. W. KING

Surveyed AUG. 14 1959, by M. BISH