


T. 13S. R. 34E. W.M.

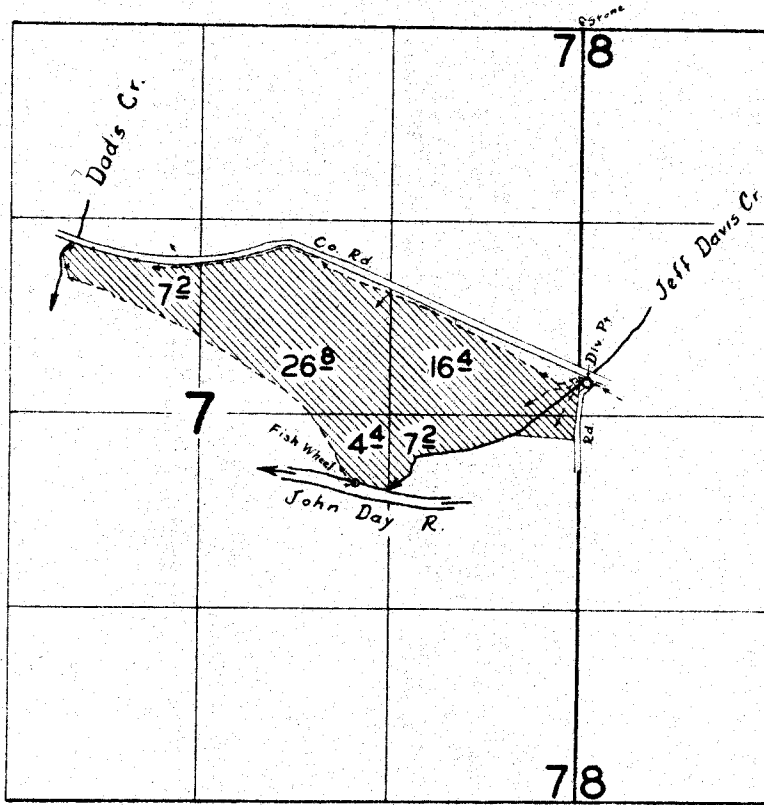

FINAL PROOF SURVEY

UNDER

Application No. 32369 Permit No. 25562

THOMAS M. VELVIN

AUG. 4 1959 M. BISH