


TWP 36 S R 4 W., W.M.

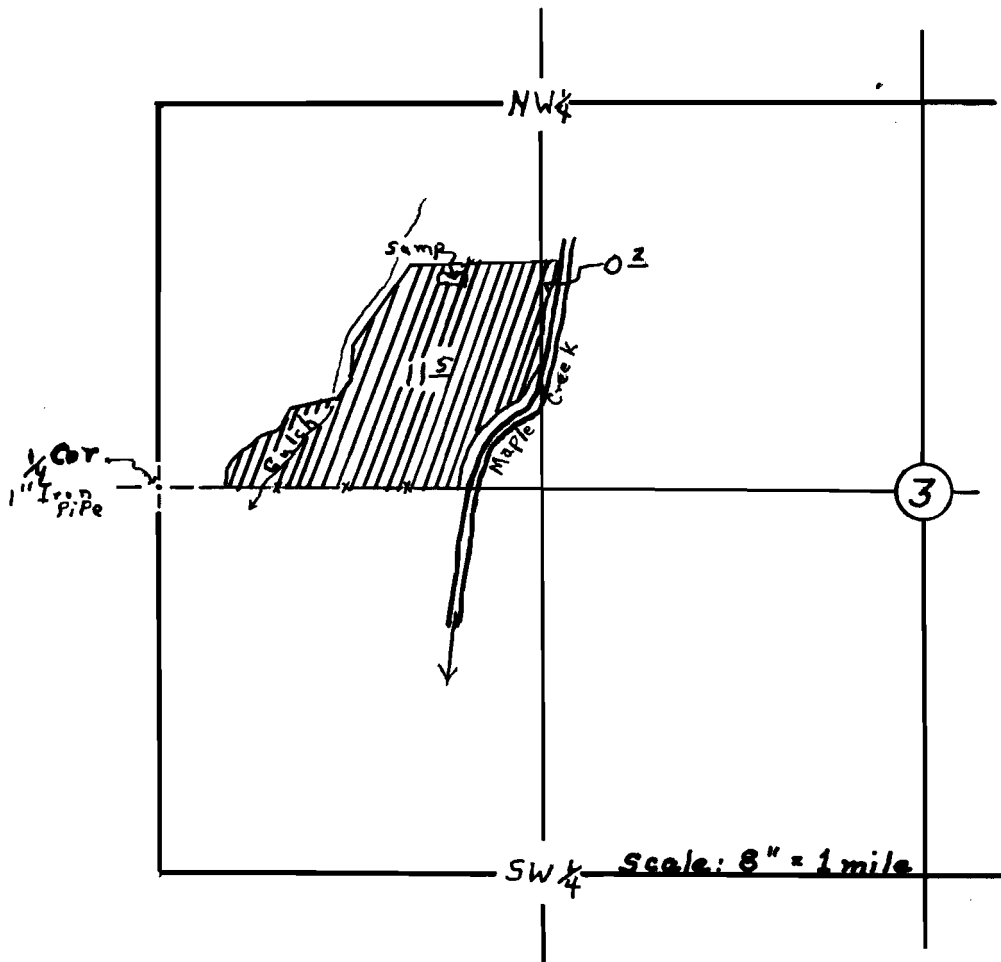

**FINAL PROOF SURVEY**  
UNDER

Application No. G 5.08 Permit No. G 402  
IN NAME OF

Raymond A. Blaine

Surveyed Oct 19, 1960, by D.C. Hendrix