


T.36S. R.2W.W.M.

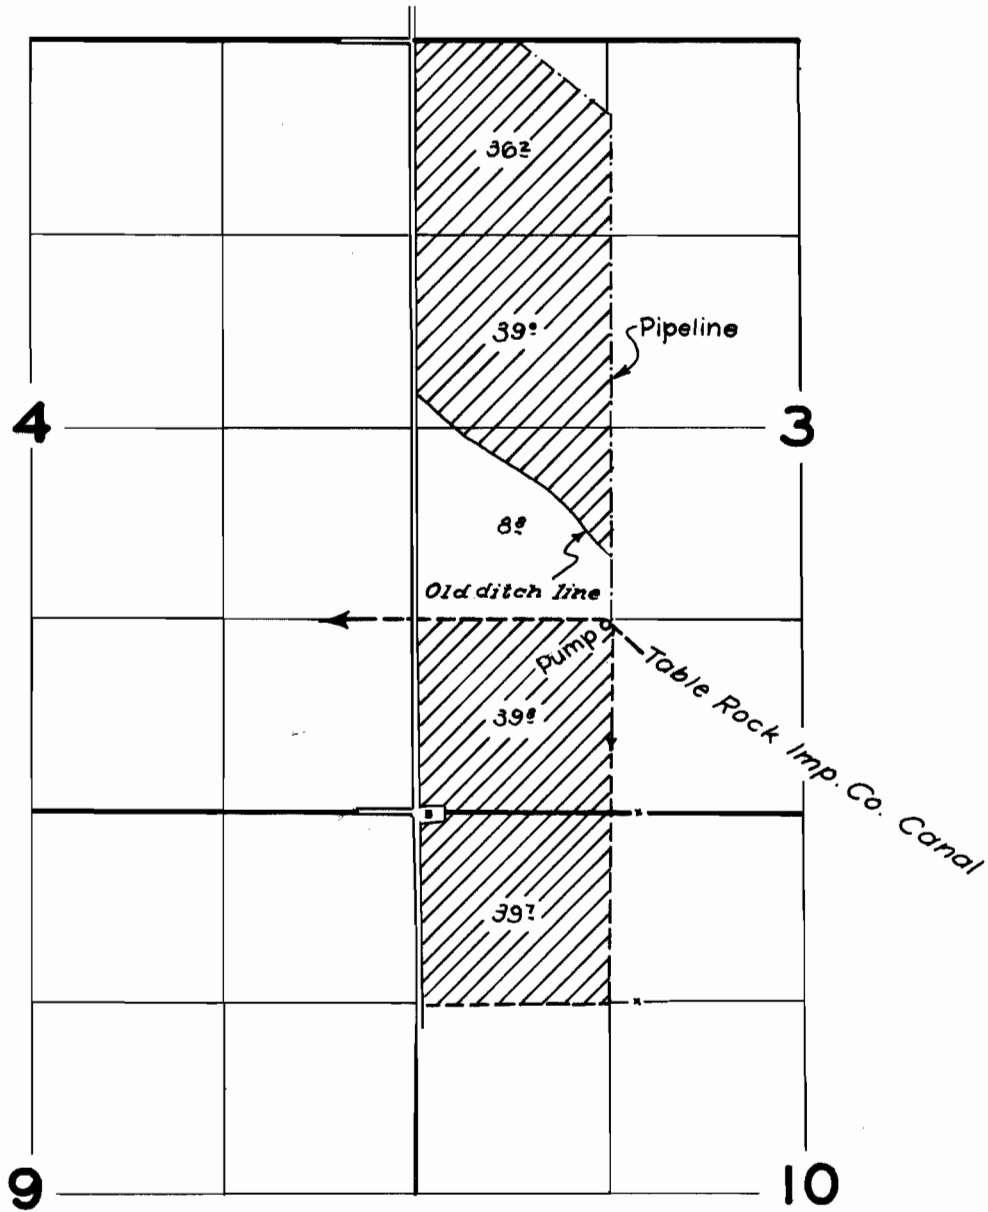

FINAL PROOF SURVEY
UNDER

Application No. 26391... Permit No. 20462
IN NAME OF

Raymond R. Reter dba Reter Fruit Co.

Surveyed April 6 1960, by *R. H. Jackson*