


20466
27964

T.40-41S.R.4E.W.M.

fermy ab. mac.
K.7

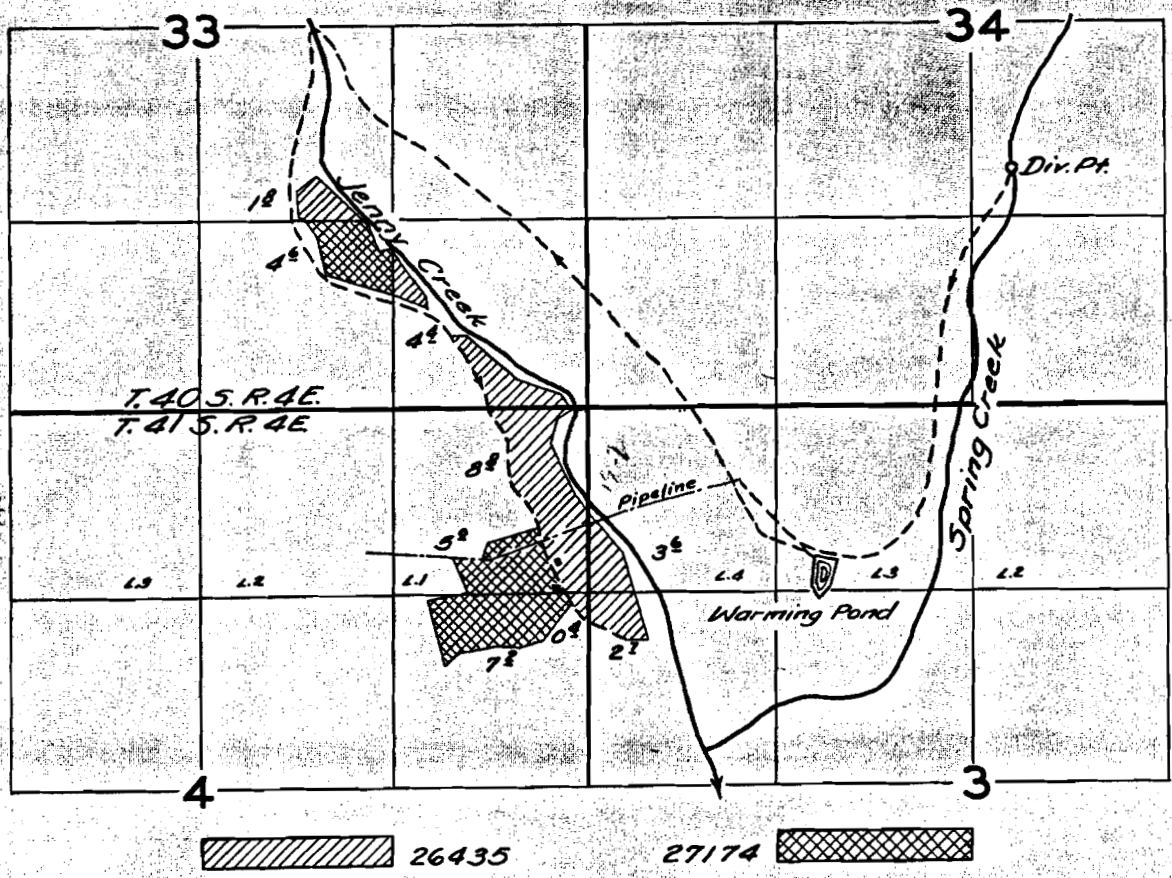

FINAL PROOF SURVEY UNDER

Application No. ²⁶⁴³⁵ 27174... Permit No. ²⁰⁴⁶⁶ 21216...
IN NAME OF

Hamilton H. Fox

Surveyed April 14 & 18 1960, by W. Bartels