


21416
27965

...-E.W.M.

Jenny Cole, misc.

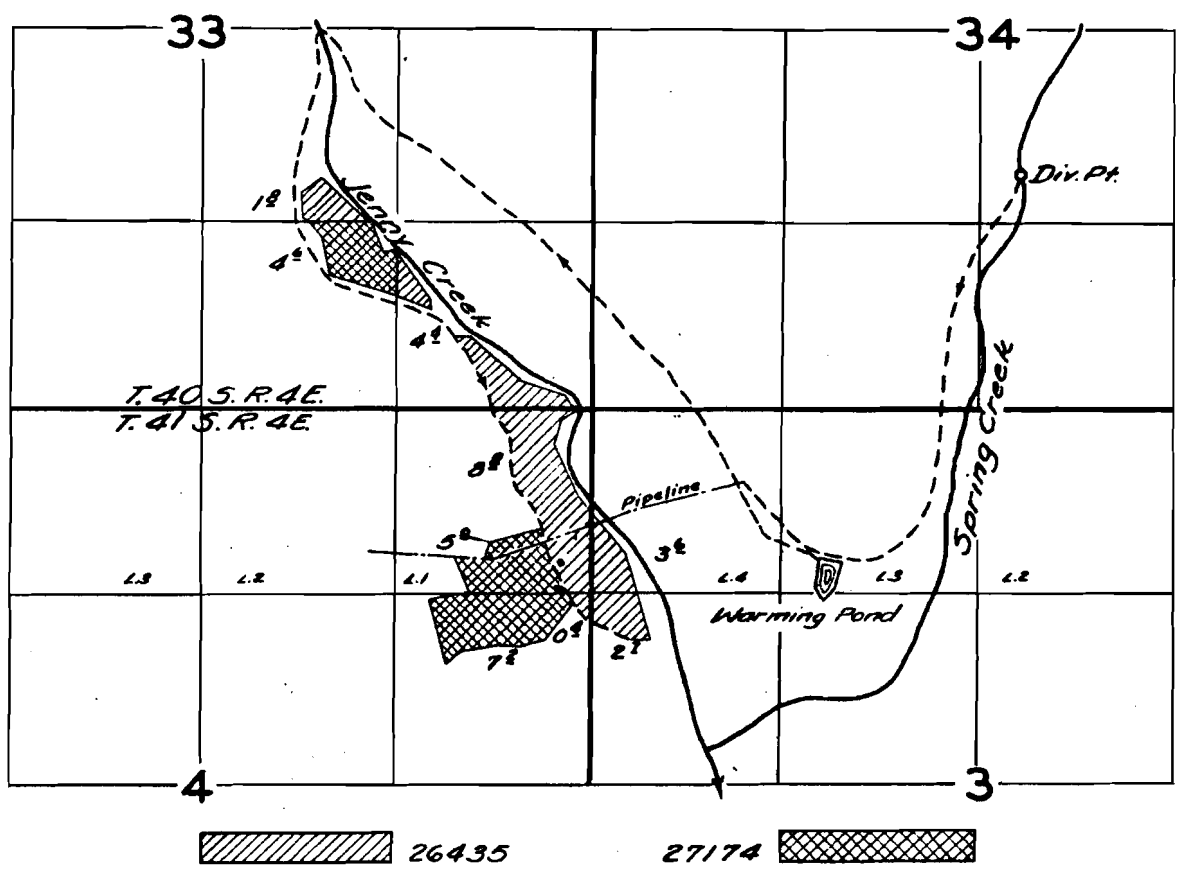

FINAL PROOF SURVEY UNDER

Application No. 26435 Permit No. 20466
IN NAME OF

Hamilton H. Fox

Surveyed April 14 & 18 1960, by C. Bartlett