


T.36S. R.1 W.W.M.

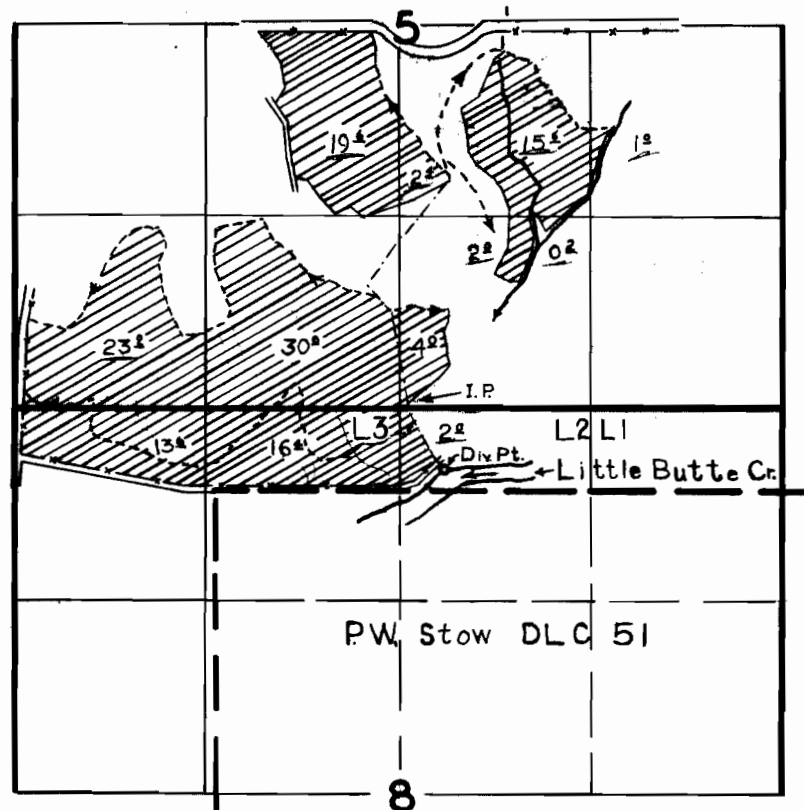

FINAL PROOF SURVEY
UNDER

Application No. 26713 Permit No. 21122
IN NAME OF

J.N. Winton

Surveyed April 11, 1960, by M. Bish