


T.35-36S.R.4 W.W.M.

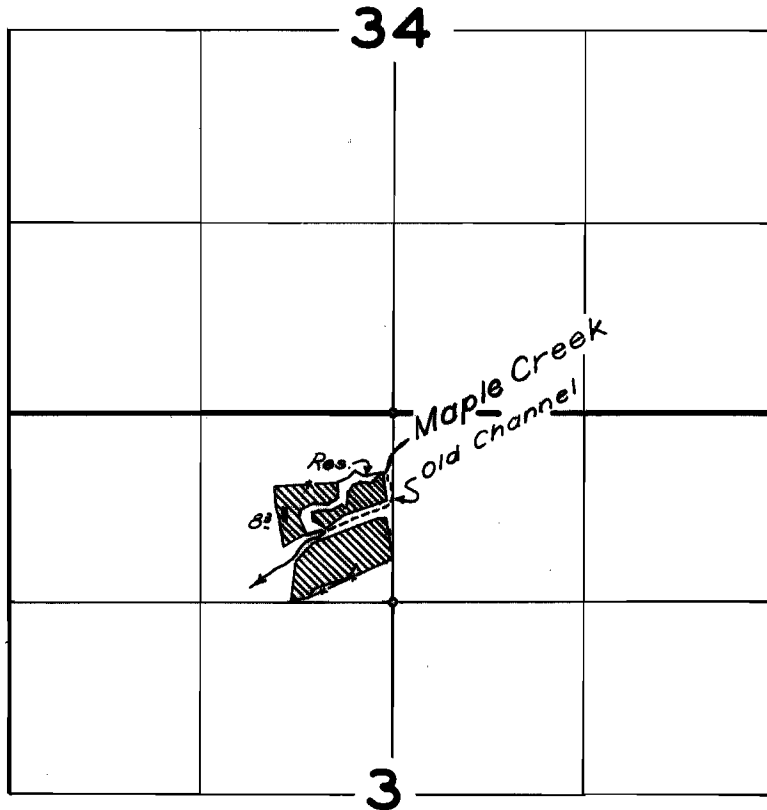

FINAL PROOF SURVEY
UNDER

Application No. ^{R-29572} 29573... Permit No. ^{R-1726} 23475...
IN NAME OF

DANIEL U. & HELEN R. CALLAHAN

Surveyed 12 April 1960, by Al Jackson