


T. 36S. R. 1W. W.M.

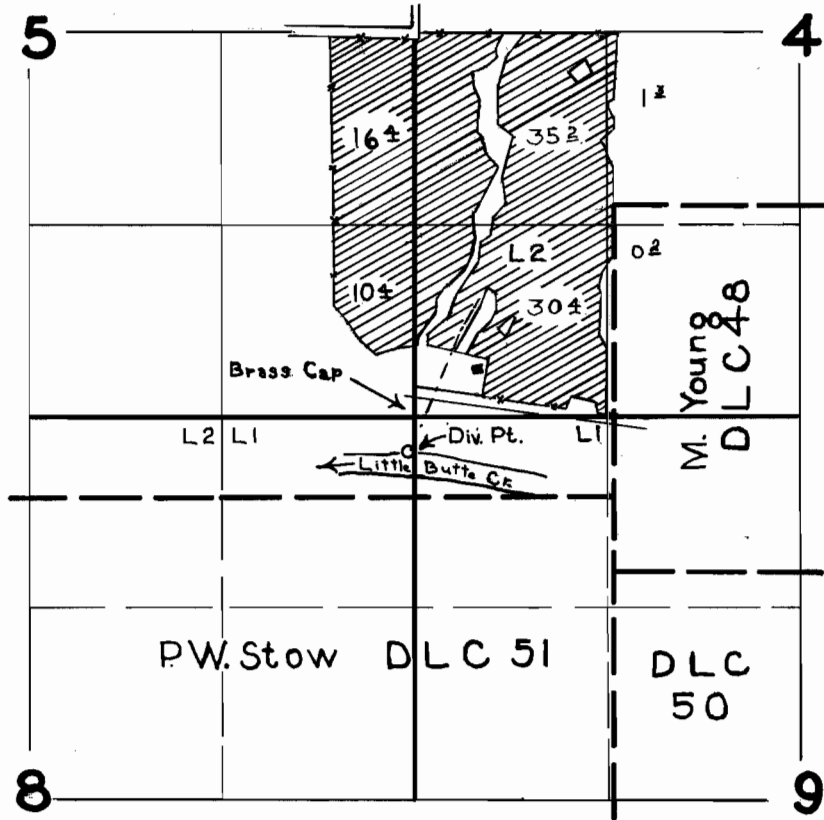

FINAL PROOF SURVEY UNDER

Application No. 308.55 Permit No. 24276.
IN NAME OF

Helen C. & Margaret A. Dugan

Surveyed April, 6, 1960, by M. Bish