


TWP 34 S., R 2 W., W.M.

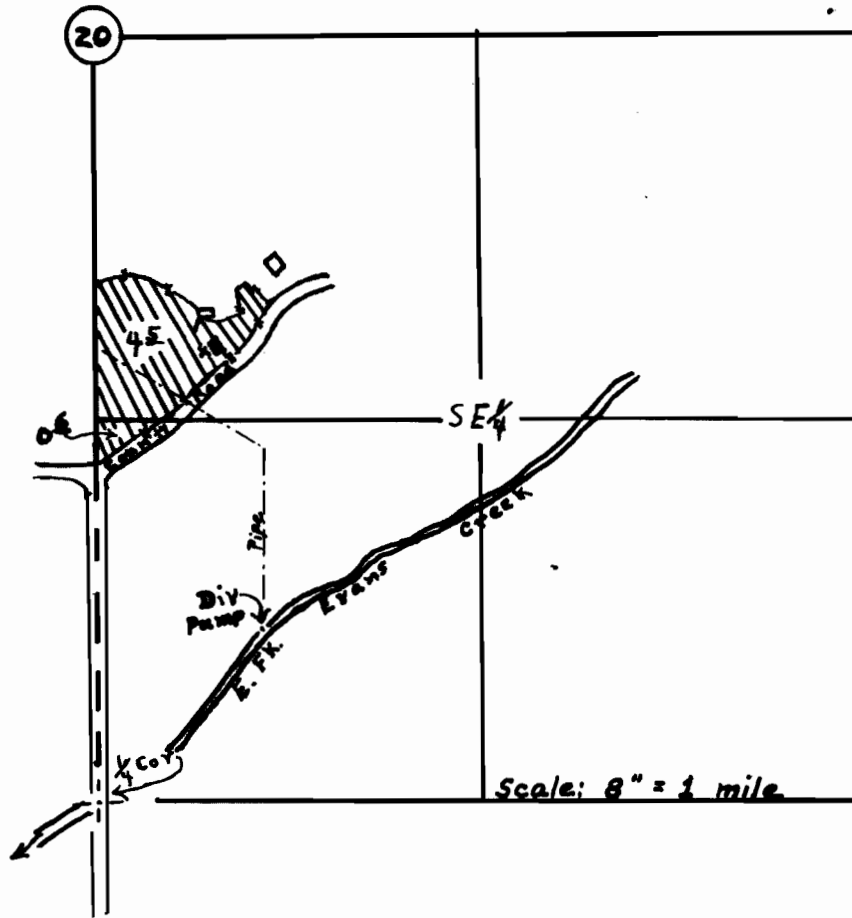

FINAL PROOF SURVEY
UNDER

Application No. 33034 Permit No. 26129
IN NAME OF

Venson A. Hunt

Surveyed Oct. 18, 1960, by RC. Hendrix.