


T37 S. R. 9 W., W.M.
Scale 4" = 1 Mile June 1952
J. G. Gallaher

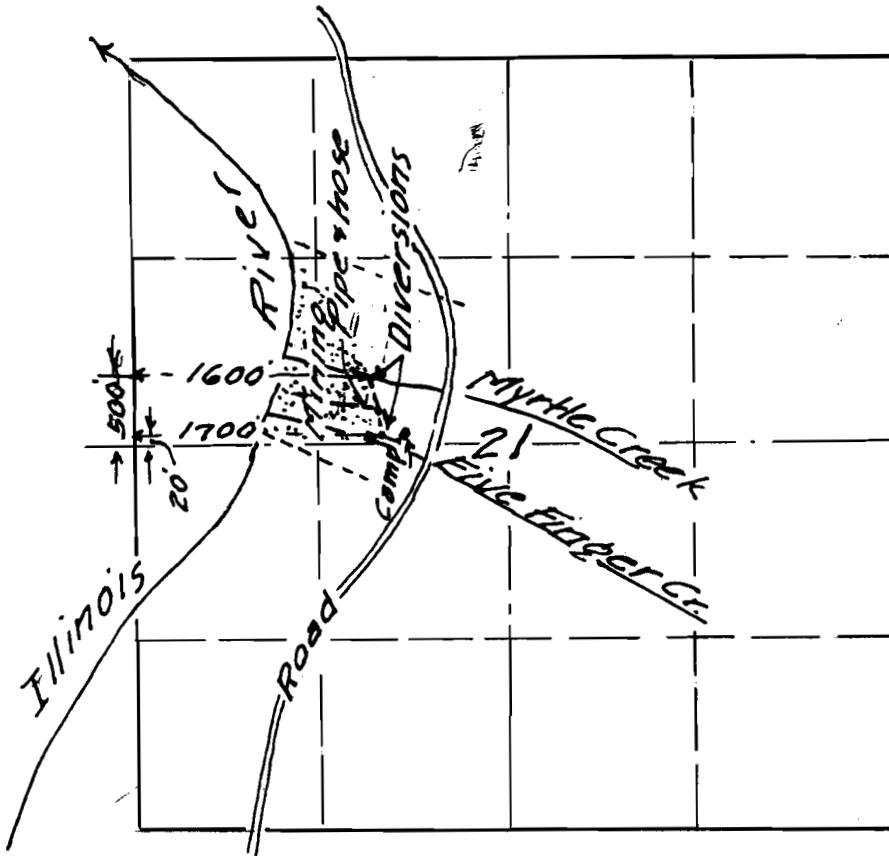

RECEIVED

JUN 27 1952

Application No. 27396

Permit No. 21561

STATE ENGINEER
SALEM, OREGON