


T.35S. R.8W. W. M.

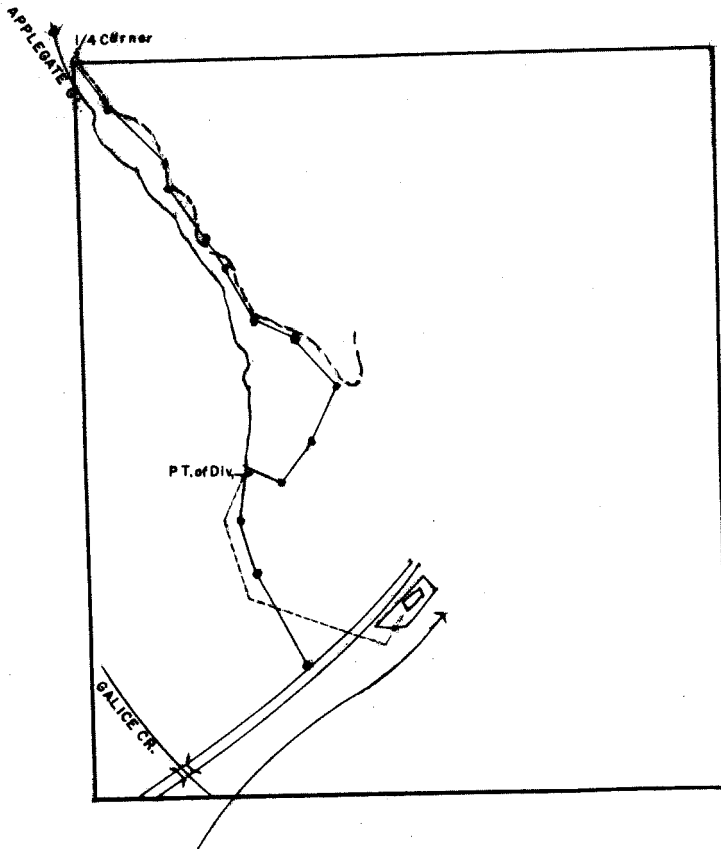

FINAL PROOF SURVEY
UNDER

Application No. 29310..... Permit No. 23033.....
IN NAME OF

..... DAVID PROW

Surveyed Oct. 26..... 1960., by Robert B. Steimer.....