


# T. 36S. R. 11 & 12E. W.M.

whiskey creek i mae.

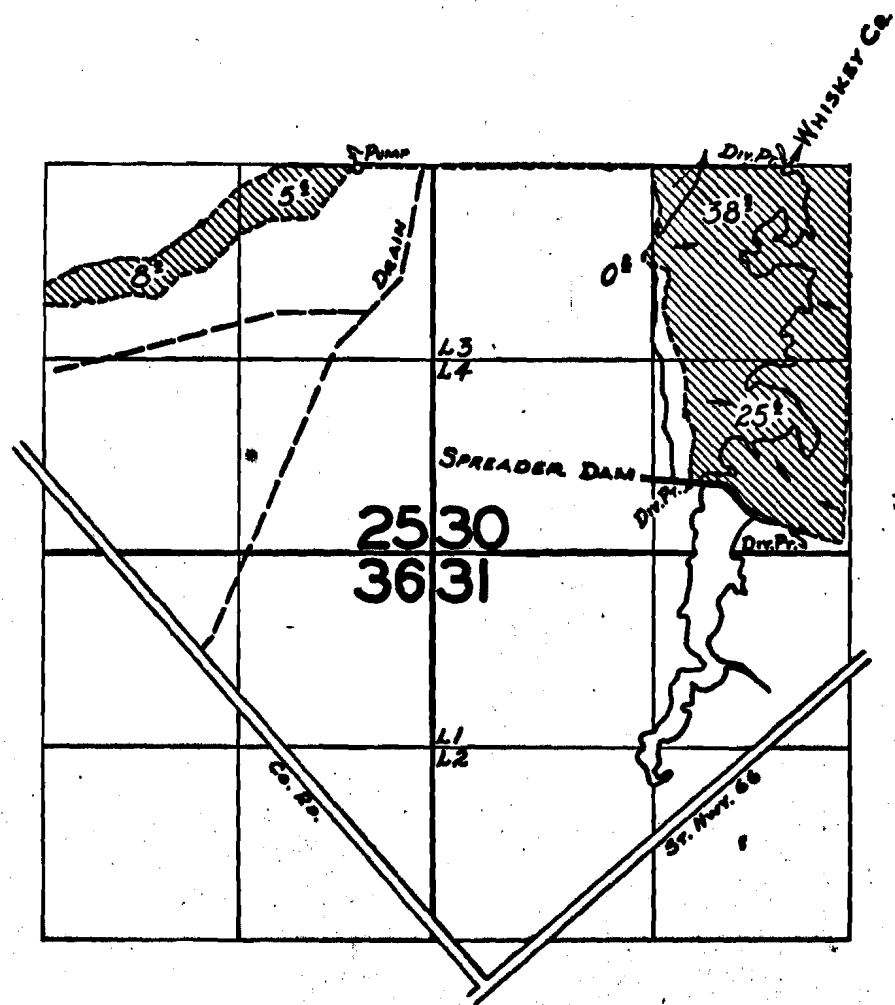

## FINAL PROOF SURVEY UNDER

Application No. 29487 Permit No. 23957  
IN NAME OF

W.M. & ELIZABETH N. WILLIAMS

Surveyed Oct. 9 1959, by P.H. JACKSON