


T.12S.,R.1W.,W.M.

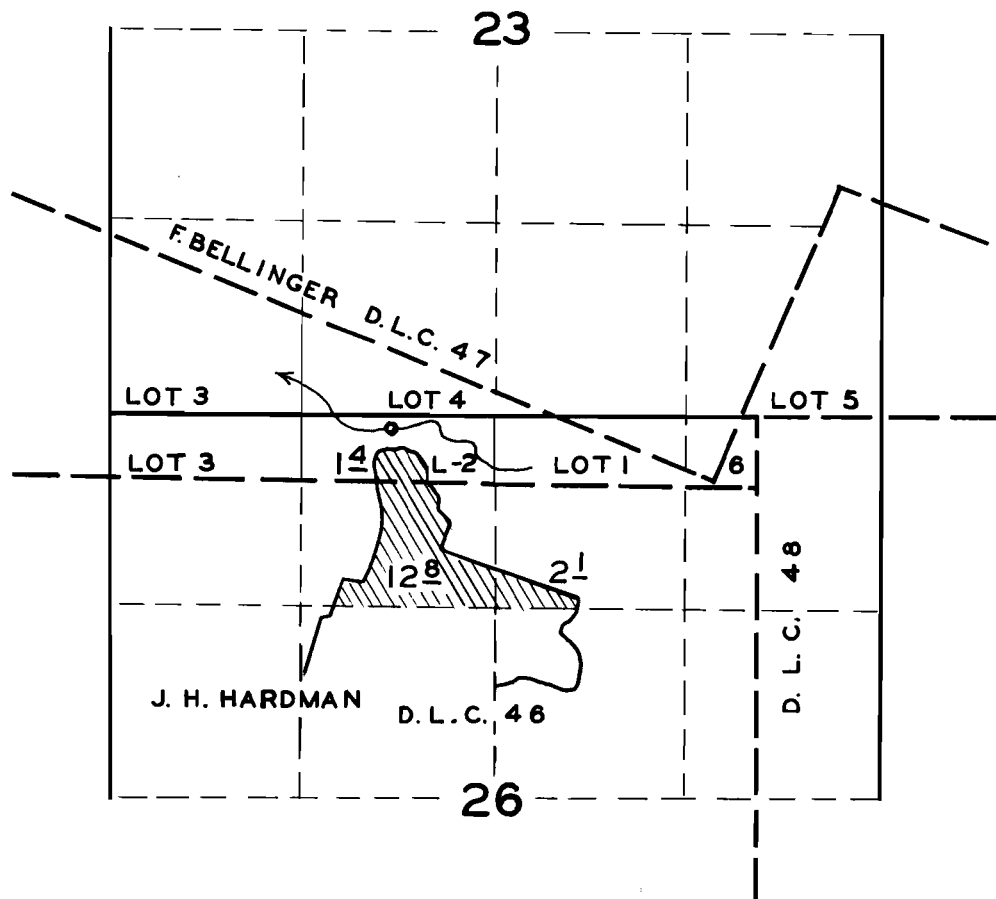

FINAL PROOF SURVEY

UNDER

Application No **25598** Permit No **20087**

IN NAME OF

CHAS. M. & MARJORIE J. BROWN

Surveyed 9-1-1959, by R.H. JACKSON