


W-472  
27978  
68716  
76224  
76225

# T.26 S.R.14 E.W.M.

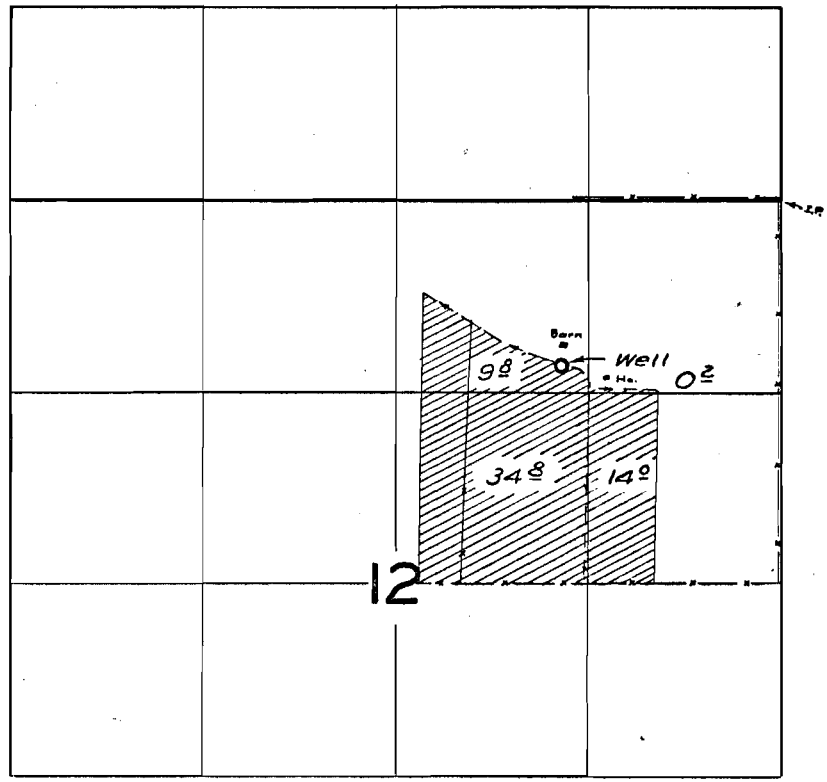

T-# 3510

## FINAL PROOF SURVEY UNDER

Application No. U-517 Permit No. U-472  
IN NAME OF

Bud Baert

Surveyed 12 May 1959, by M. Bish

2-18-52