T.16 S. R. 4 W.W.M.

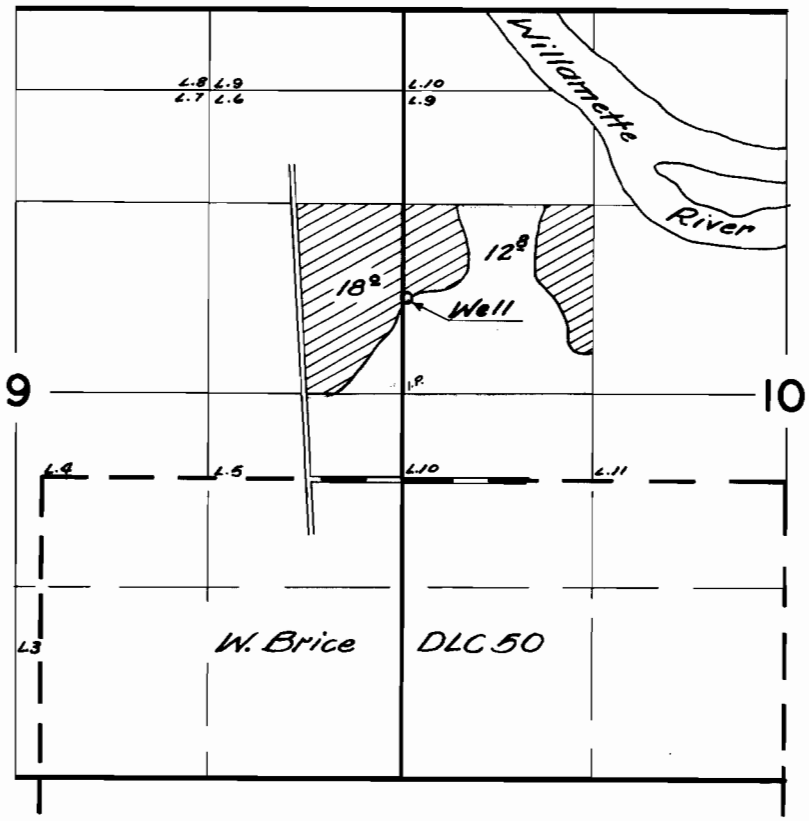

FINAL PROOF SURVEY
UNDER

Application No. G-642 Permit No. G-558
IN NAME OF

Harold Edwards

Surveyed April 25 1960, by C.O. Bartlo

DBQ-4N-143