


T.16S.R.4W.W.M.

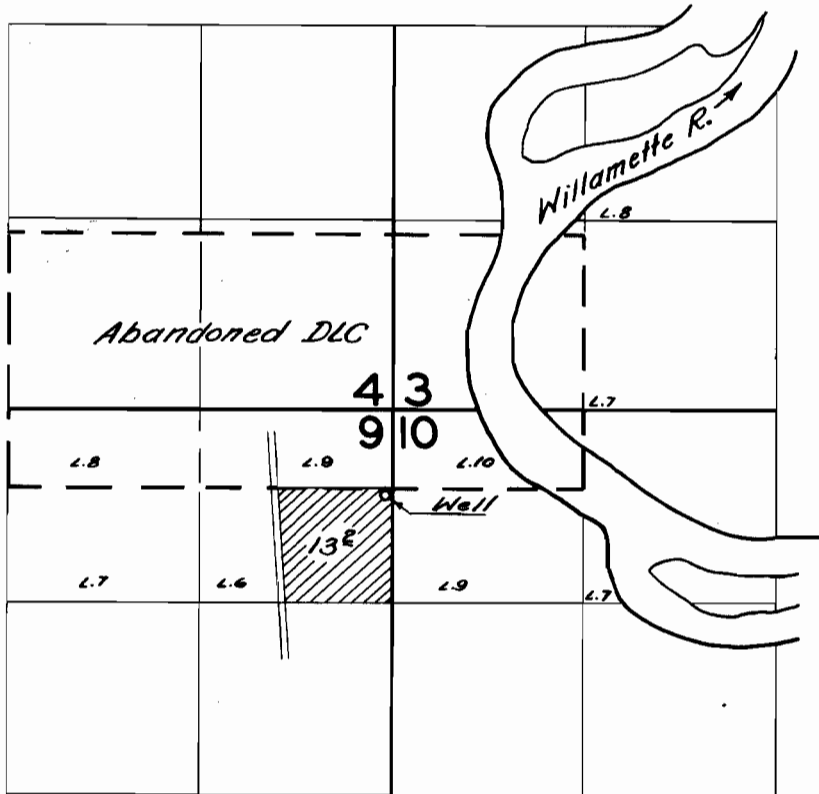

FINAL PROOF SURVEY
UNDER

Application No. G-617 Permit No. G-587
IN NAME OF

Jacob C. Jager, Jr.

Surveyed April 25, 1960, by C. O. Baugh