


T.17S. R.4W.W.M.

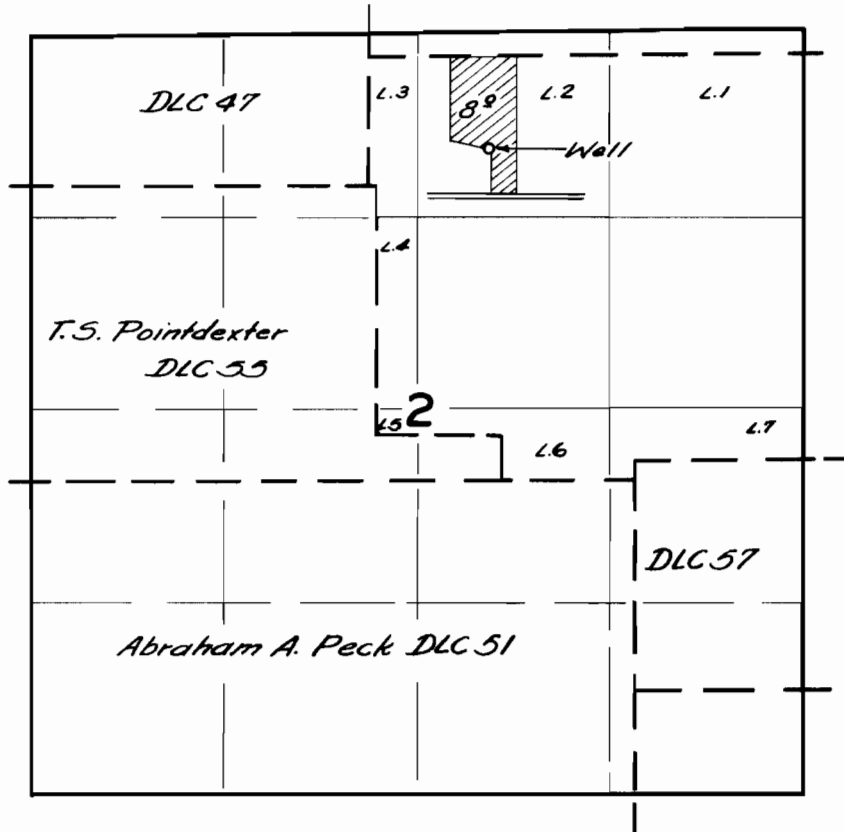

FINAL PROOF SURVEY UNDER

Application No. *G-294*... Permit No. *G-782*...
IN NAME OF

Melvin Loren Thompson

Surveyed *May 2*, 1960, by *C.O. Bartels*