


T.16 S.R. 4W.W.M.

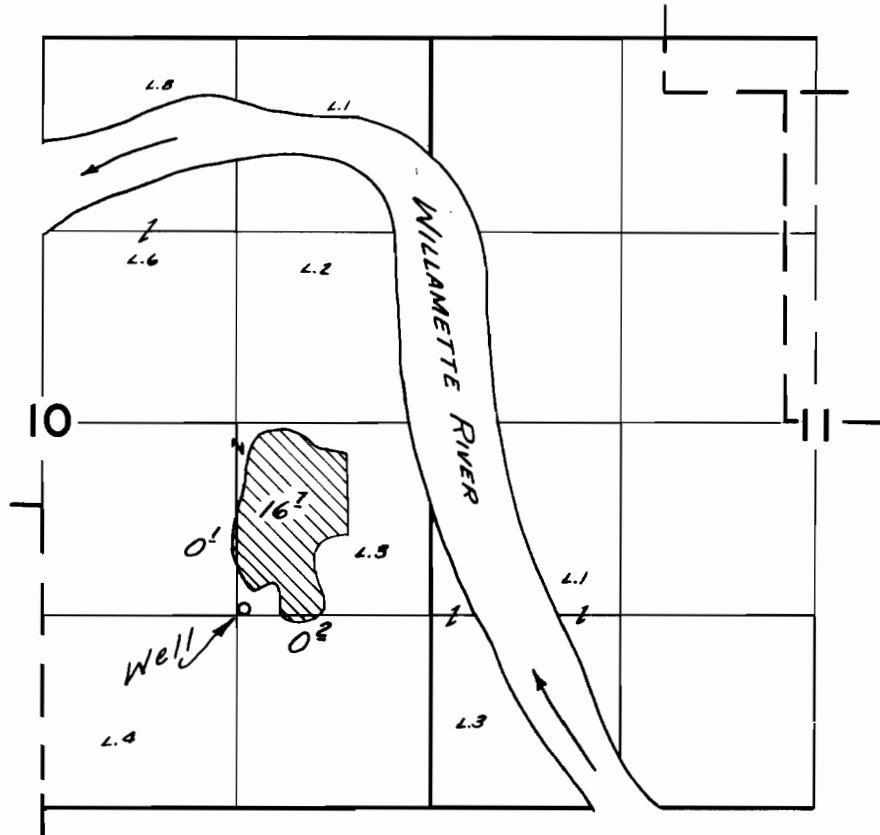

FINAL PROOF SURVEY UNDER

Application No. *G-991*..... Permit No. *G-874*.....
IN NAME OF

.....*Ralph C. Templeton*.....

Surveyed *April 28* 1960, by *C.O. Banta*.....