


T.16S.R.4W.W.M.

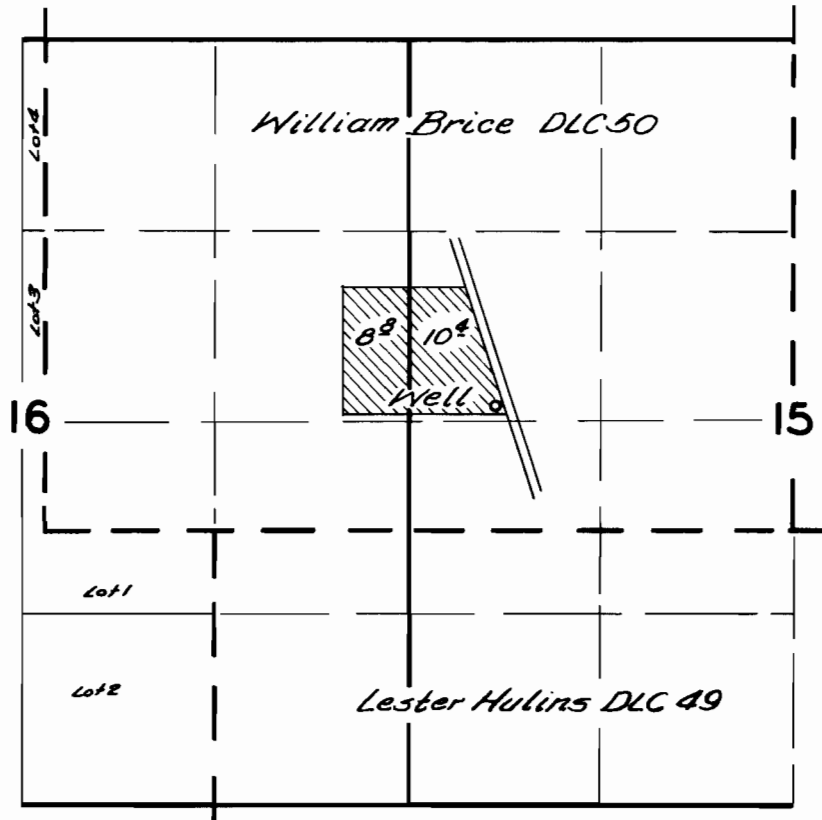

FINAL PROOF SURVEY
UNDER

Application No. *G-935* Permit No. *G-887*
IN NAME OF

William Harper

Surveyed *April 27 1960*, by *C. B. Burt*