


T.16S. R. 4W.W.M.

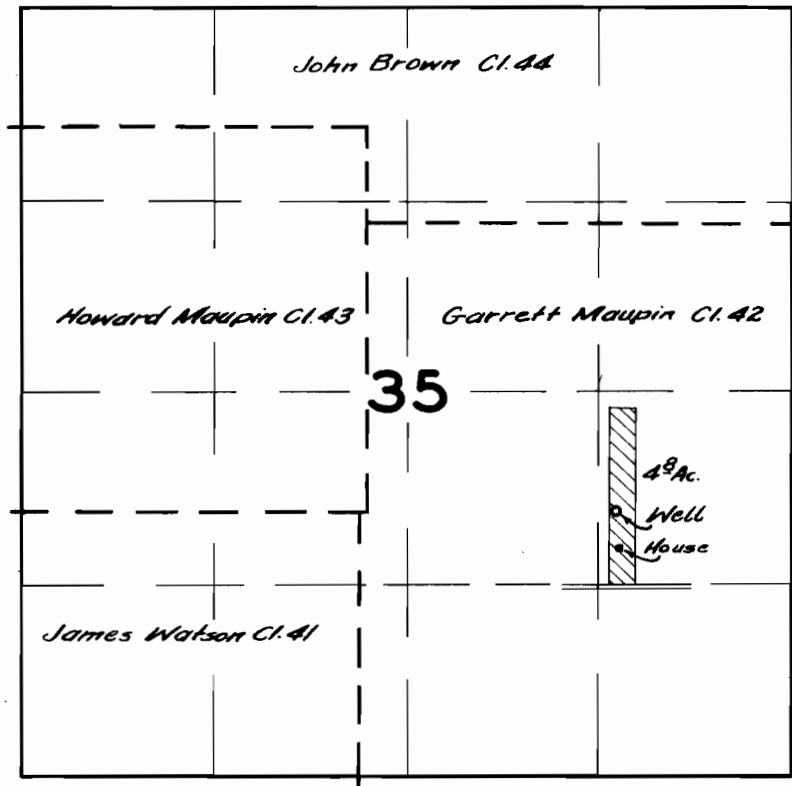

FINAL PROOF SURVEY
UNDER

Application No. G-1075. Permit No. G-1149.
IN NAME OF

.....*CHARLES WESLEY THOMPSON*.....

Surveyed *March 27 1959*, by *COBATT*.....